


T.25S. R.13 W.W.M.

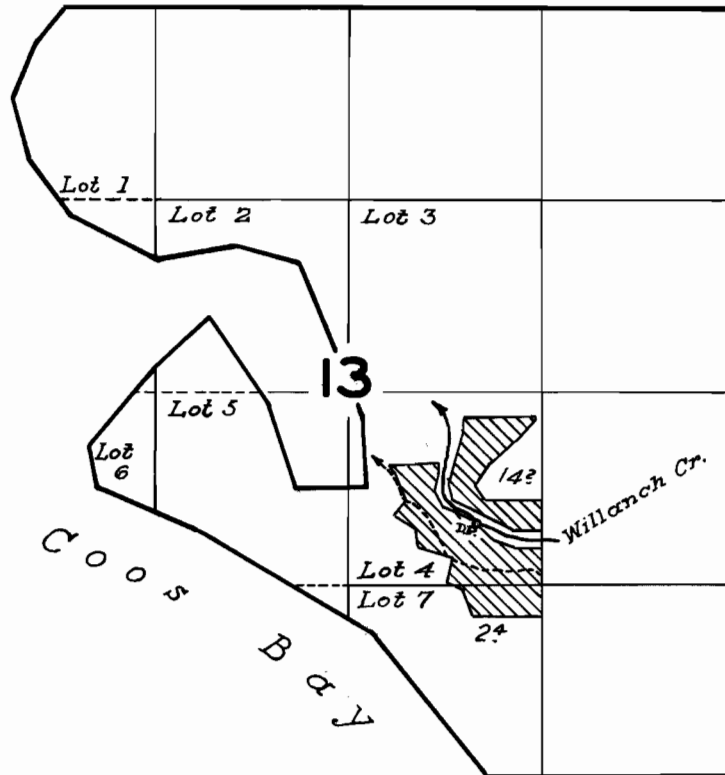

FINAL PROOF SURVEY  
UNDER

Application No. 29328 Permit No. 23929  
IN NAME OF

EDMOND ERWIN

Surveyed July 14, 1958, by M. Bish  
June 14 1960 R. Jackson