


T.27&28S.R.11W.W.M.

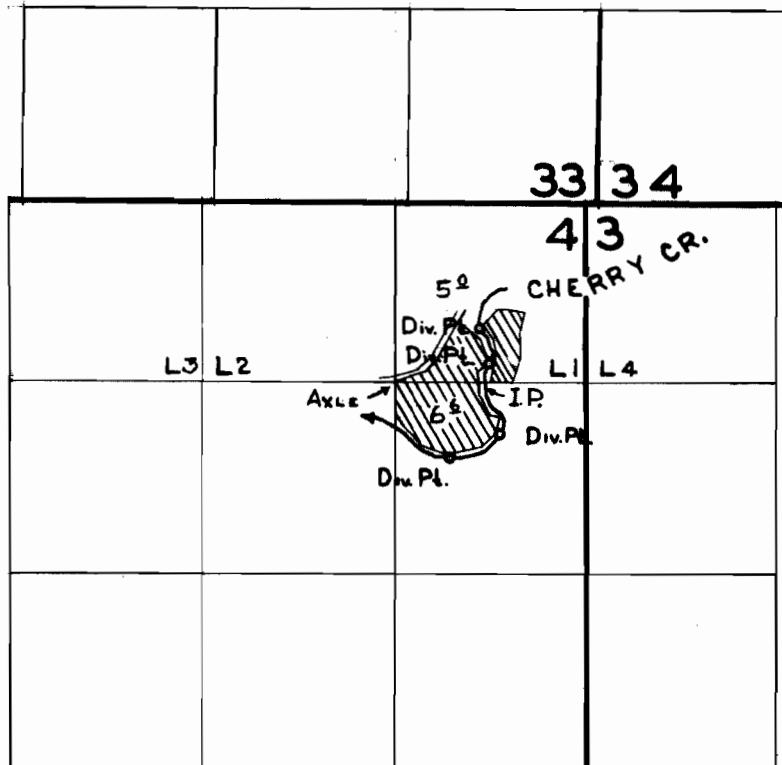

FINAL PROOF SURVEY UNDER

Application No. 31268 Permit No. 24633
IN NAME OF

.....FRANK J. KAISER.....

Surveyed JUNE 10 19.60, by M. BISH.....