


T.24S.R.13W.W.M.

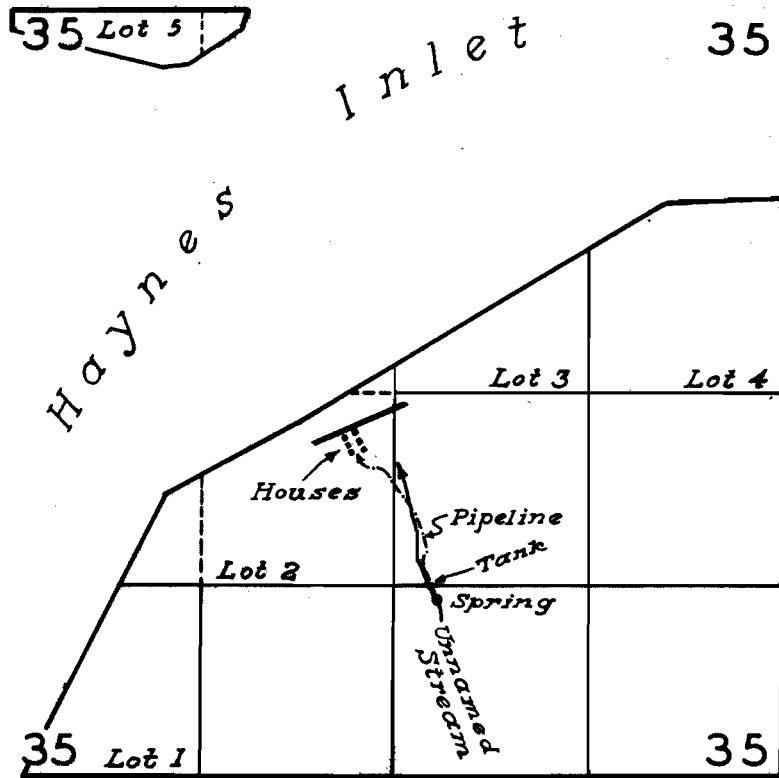

FINAL PROOF SURVEY
UNDER

Application No. 32423.. Permit No. 25596.
IN NAME OF

CLARENCE L. & MARY STODDARD

Surveyed June 15 1960., by *R. Jackson*