


T. 20 S. R. 9 W. W.M.

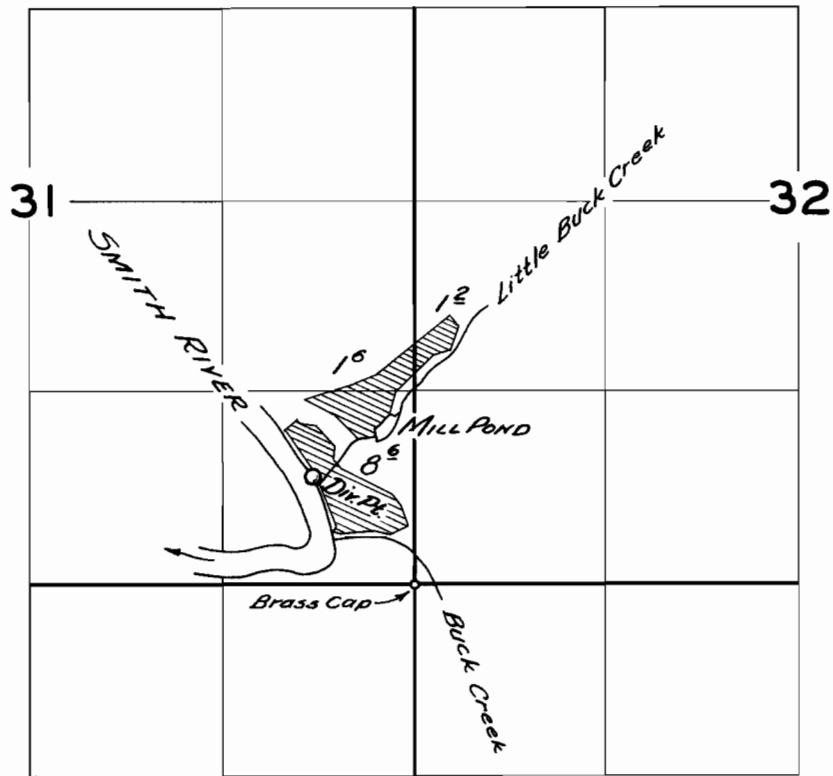

FINAL PROOF SURVEY
UNDER

Application No. 30917 Permit No. 24373
IN NAME OF

Oscar W. & Otto C. Olson

Surveyed June 28, 1960, by C. O. Bartels