


T.36S. R.2 W.W.M.

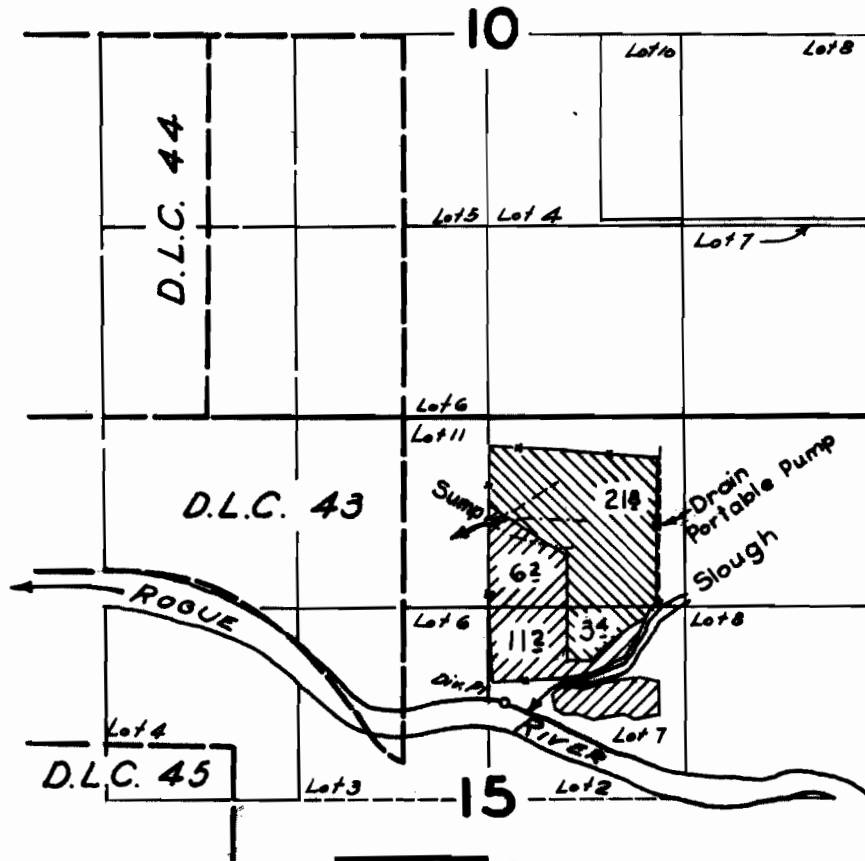

FINAL PROOF SURVEY
UNDER

Application No. 29768 Permit No. 23678
IN NAME OF

E. H. TAYLOR

Surveyed April 5, 1960, by *R. Jackson*