


T.36S.R.3W.W.M.

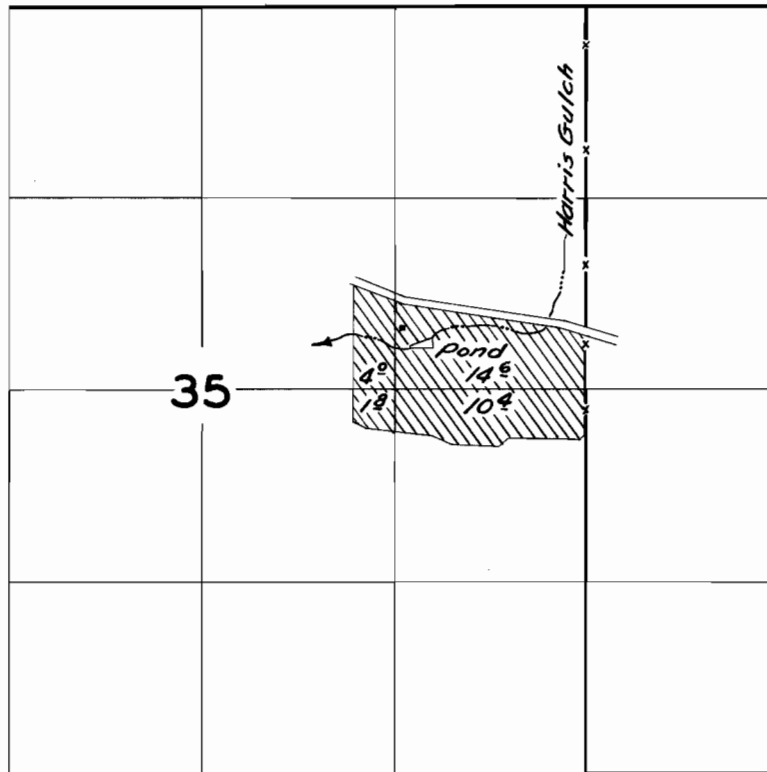

FINAL PROOF SURVEY
UNDER

Application No. ^{R-29443}~~29444~~ Permit No. ^{R-1809}~~23933~~
IN NAME OF

KENNETH P. LAMB

Surveyed April 5 1960, by C.O. Baile