


T.36S. R.3W.W.M.

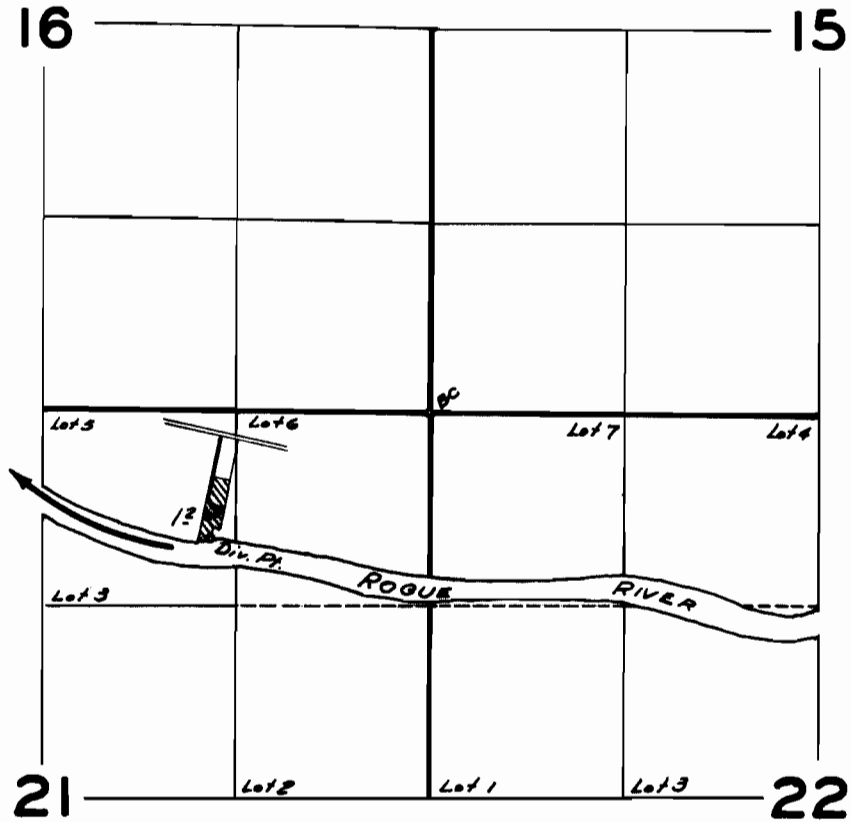

**FINAL PROOF SURVEY**  
UNDER

Application No. 30618... Permit No. 24122...  
IN NAME OF

K. L. RICHARDSON

Surveyed 14 April 1960, by R. Jackson