


T.34-35 S. R. 4 W. W.M.

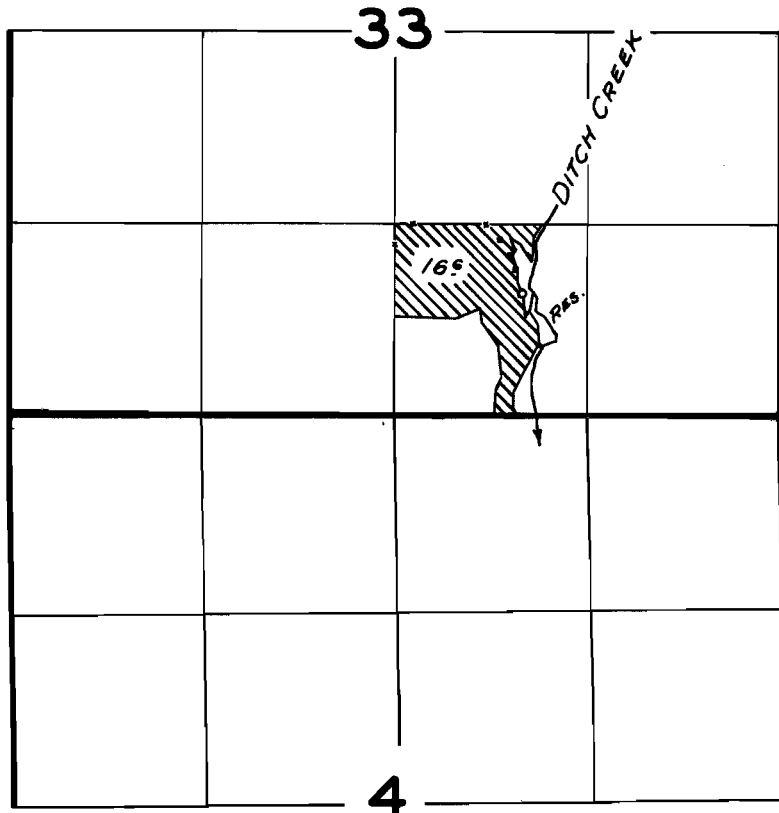

FINAL PROOF SURVEY
UNDER

Application No. ^{R-30977} 30978 Permit No. ^{R-1899} 24379
IN NAME OF

EDWIN F. HIGGINS

Surveyed 11 April 1960, by E. Jackson