

TWP 34 R 8 WWM

TWP 34 R 7 WWM

13

18


24

19

Cor. Found 2X4 wired
to Oak + rock pile

Pt. of Div. 2 springs
25' apart

Pt. of Div pump

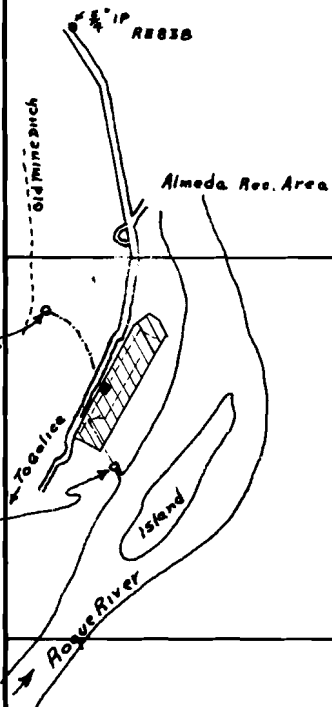

Final Proof Survey Mark Krysto
APP 22181 Per 17691
Scale 8"=1 Mi. Oct. 21 1960 by RB Steimer WM