


T. 35S. R. 6W. W.M.

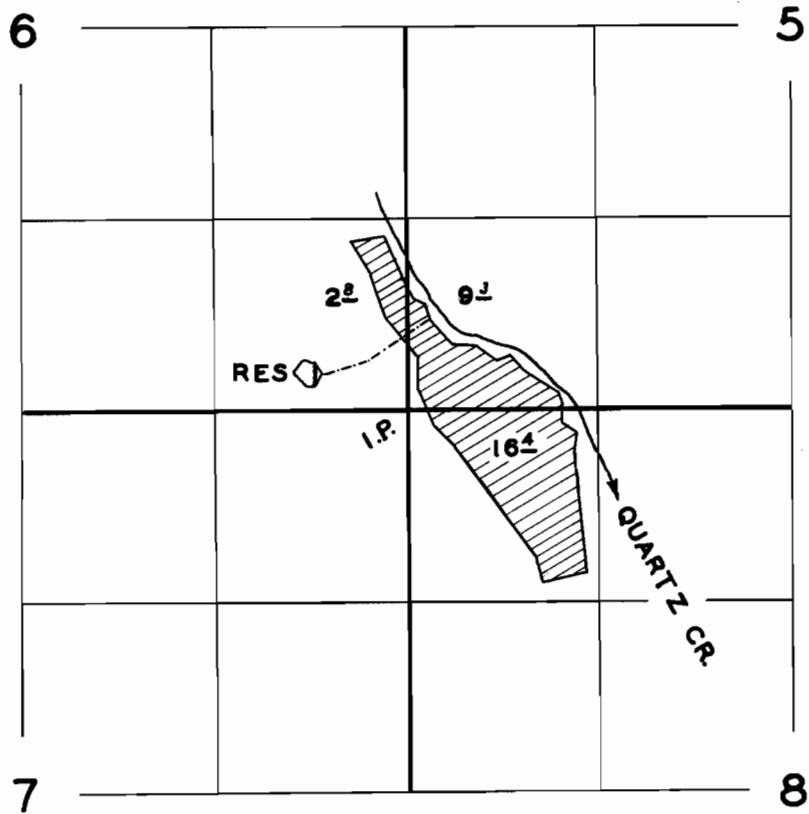

FINAL PROOF SURVEY
UNDER

Application No. R29136 29137 Permit No. R1621 22929
IN NAME OF

ESTATE OF EMMETT COCHRANE

Surveyed SEPT. 30. 1960, by C. O. BARTELS