






U-243  
282001

# T.38S. R.11 1/2 E.W.M.

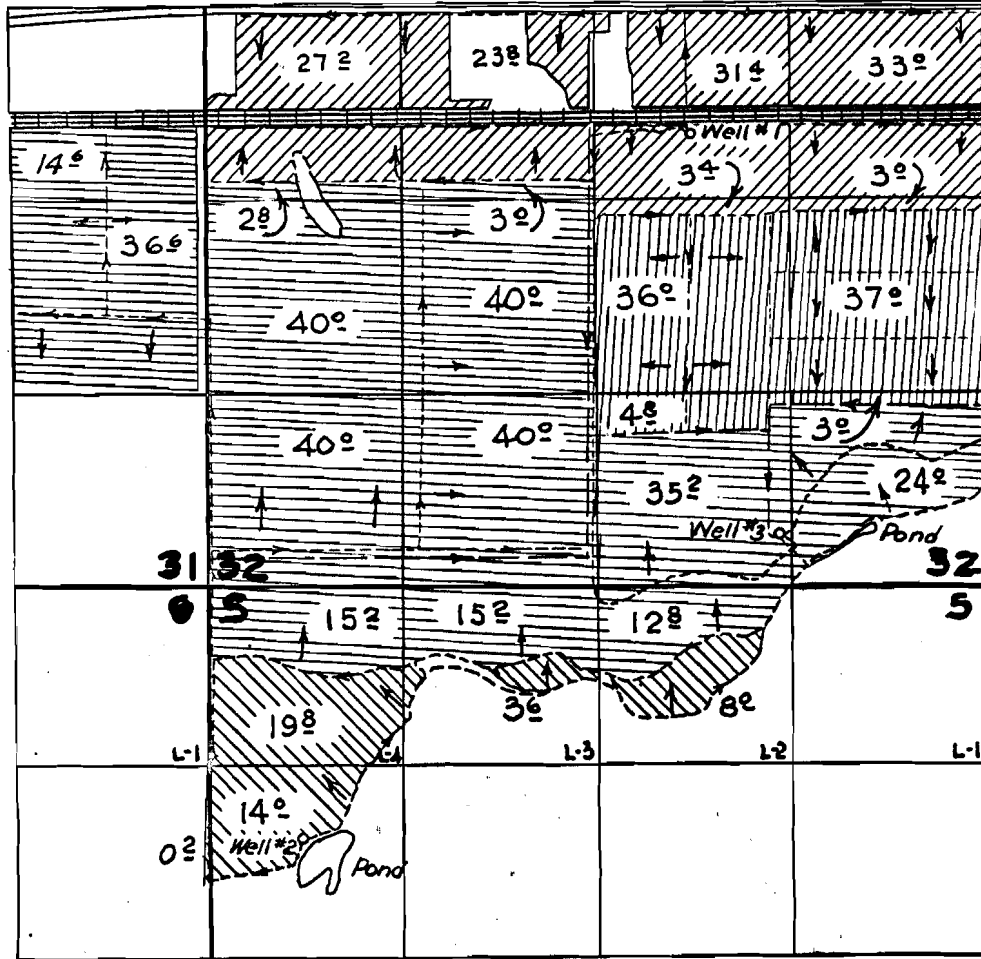

Well #1   
 Well #2   
 Wells 2 & 3   
 Wells 1, 2, & 3 

## FINAL PROOF SURVEY UNDER

Application No. U-271.. Permit No. U-243  
IN NAME OF

**L.L. & DELILA P. PORTERFIELD**

Surveyed 30 April, 1958., by C.O. Bartels

Swan Lake wells