


# T.33S. R. 6E. W.M.

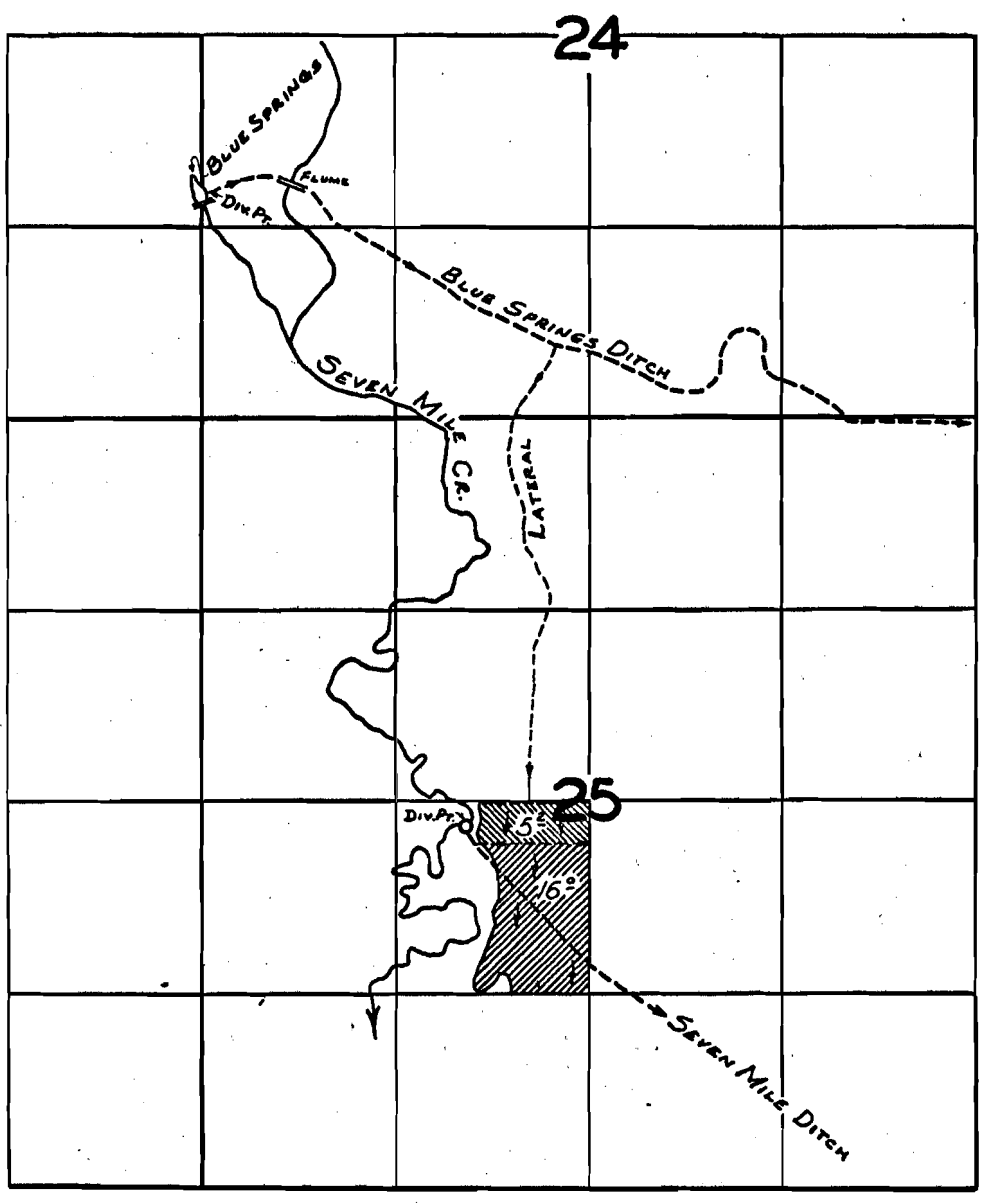

Sevenmile creek

## FINAL PROOF SURVEY UNDER

Application No. 28990 Permit No. 23668  
IN NAME OF

LOREN MILLER CO.

Surveyed OCT. 8 1959, by R. H. JACKSON