


23404
28205

High Water Cor. & Mark.

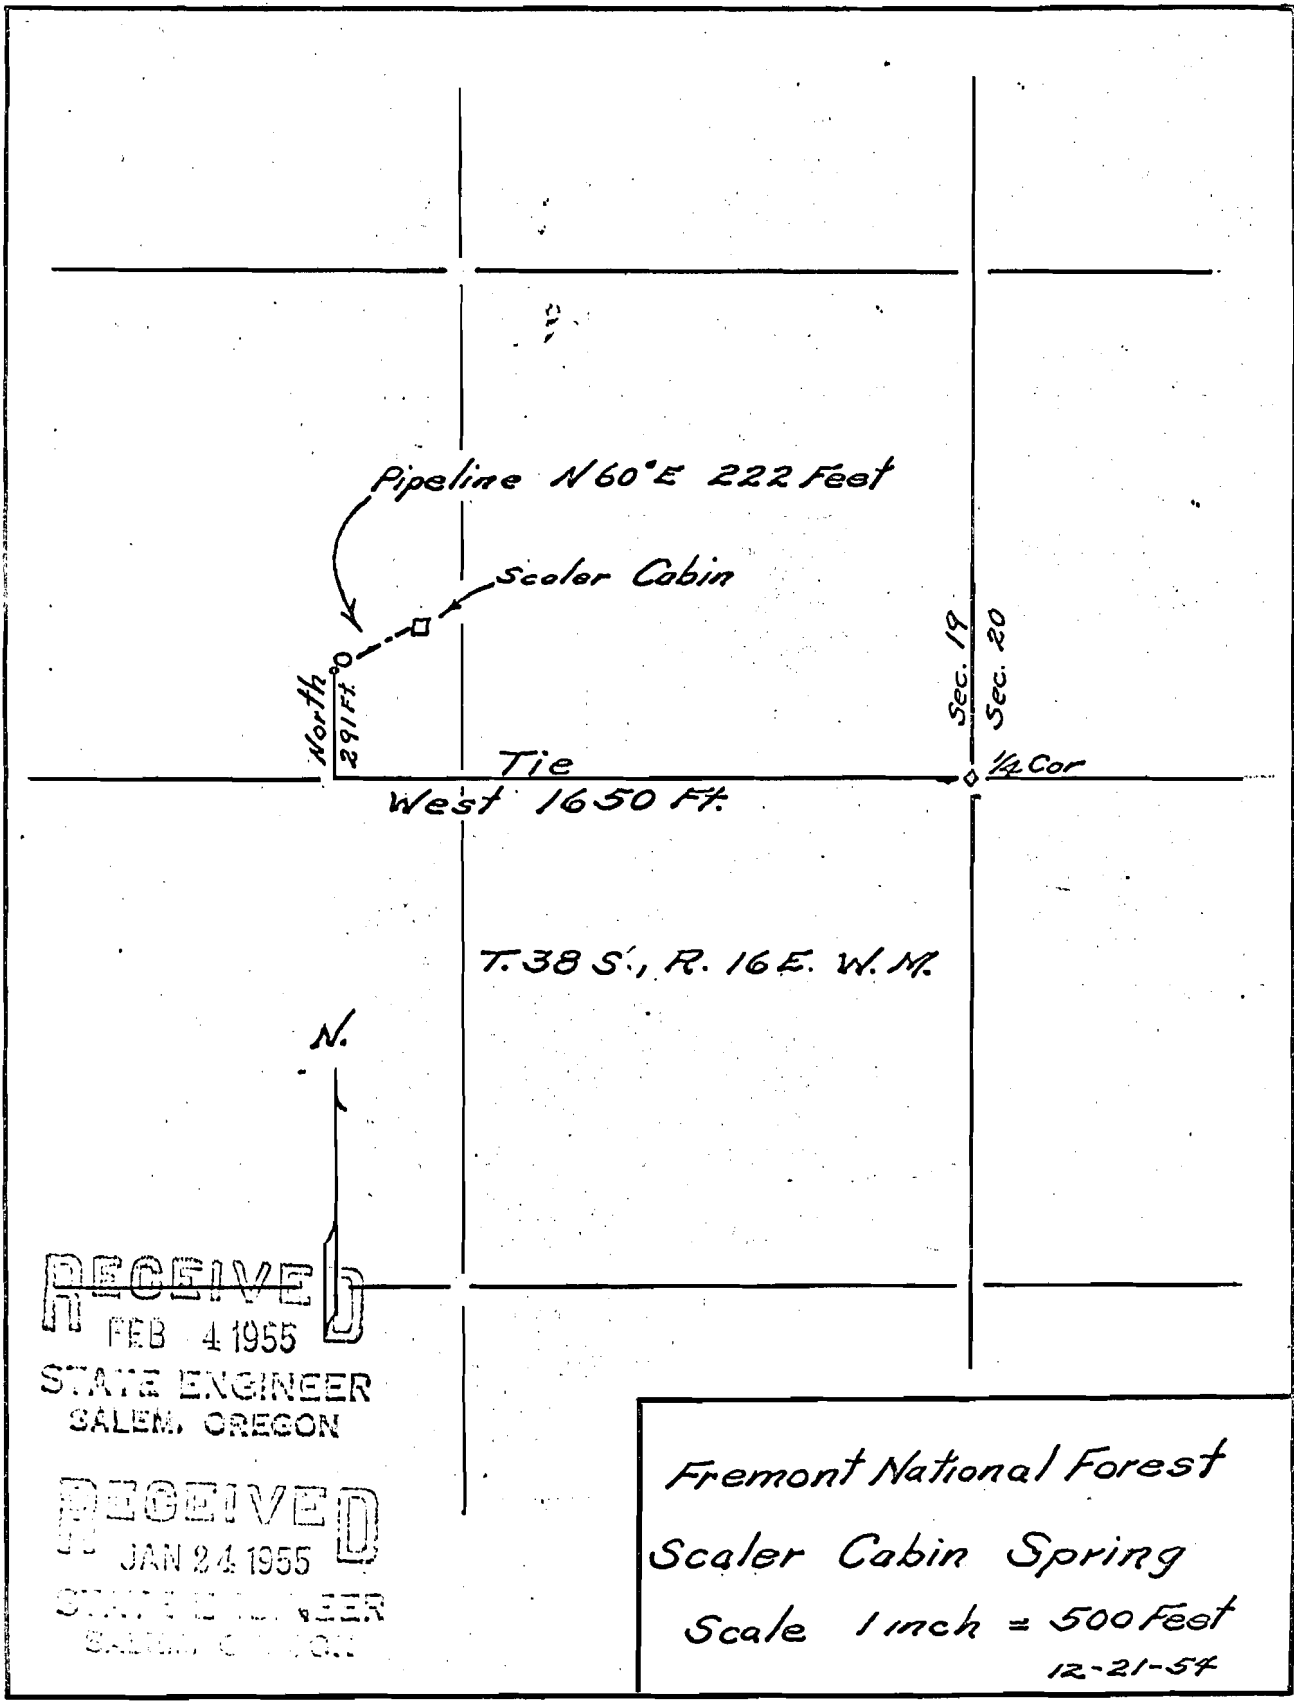

Application No. 29727
Permit No. 23404

29727