


23405
28206

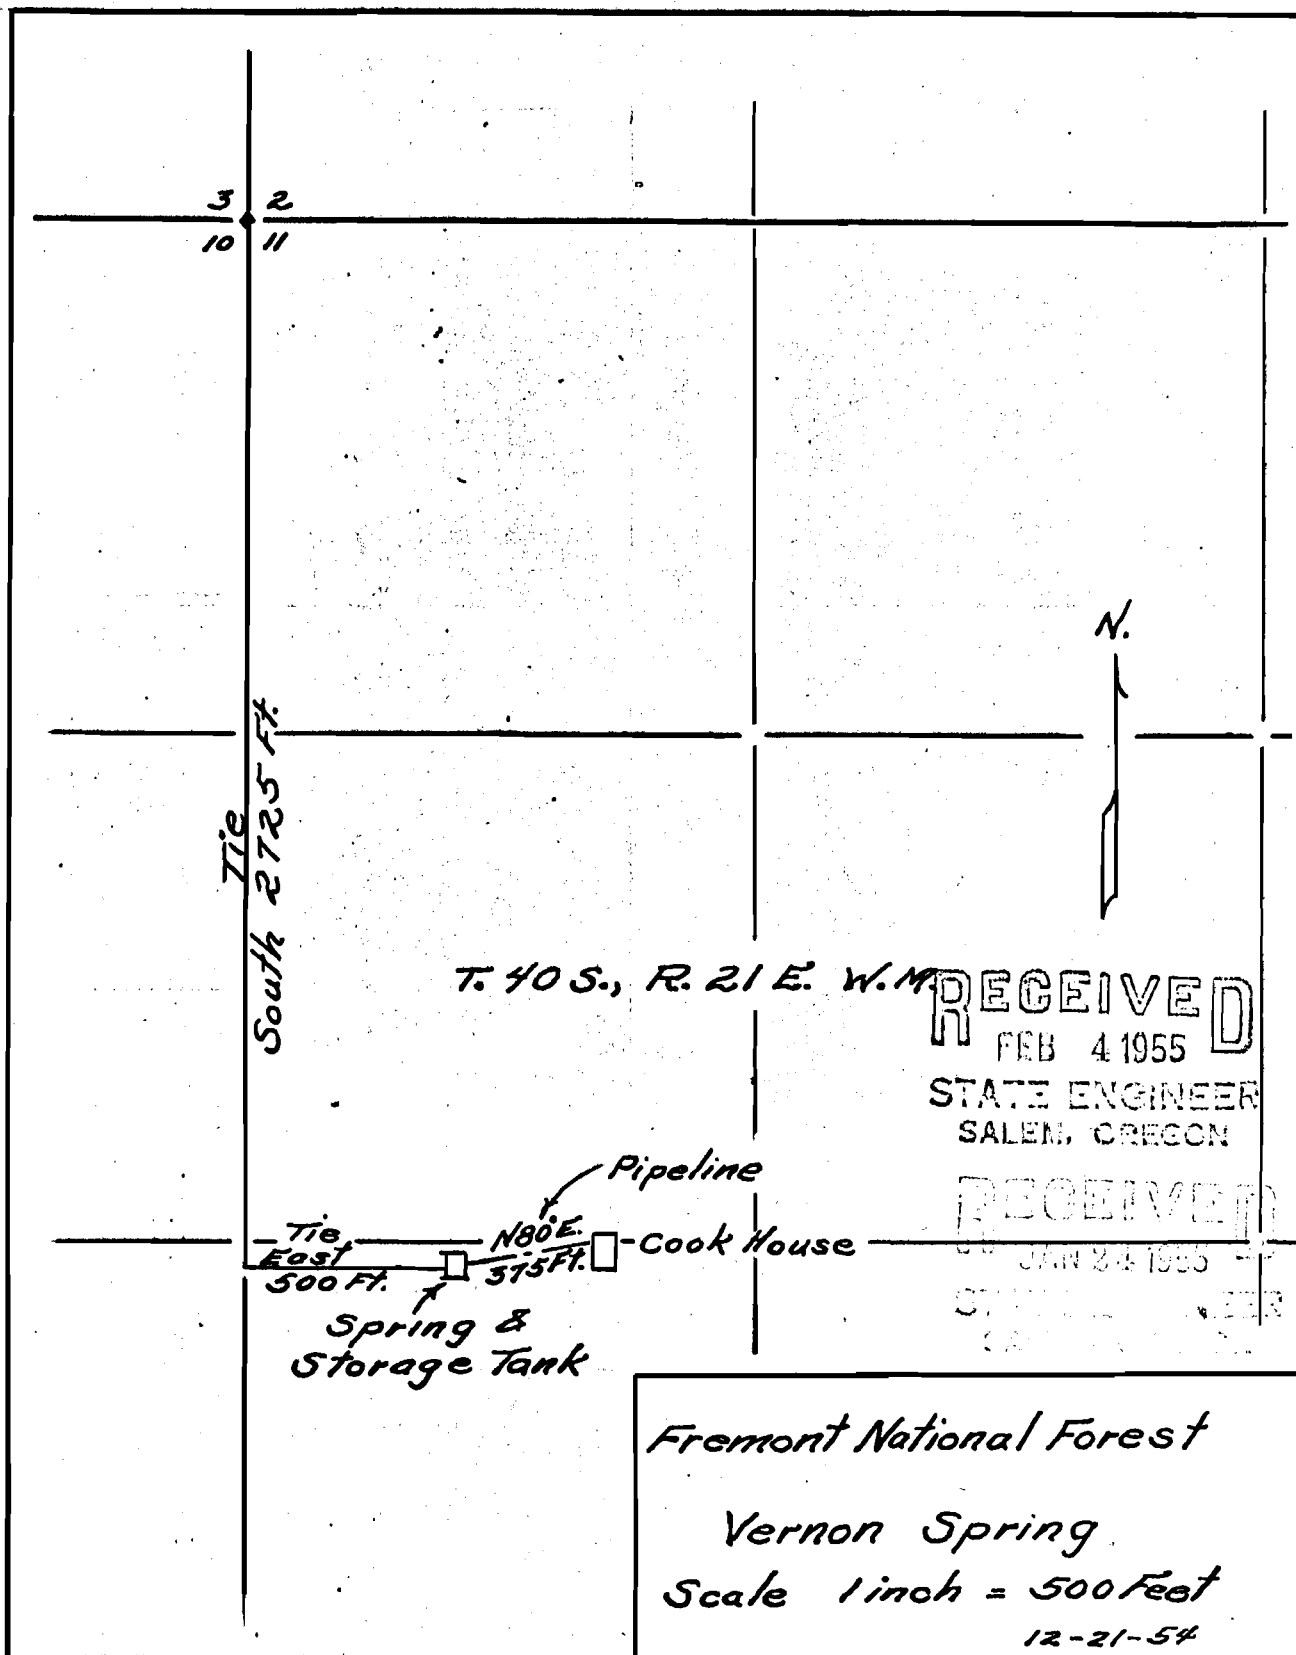

Application No. 29728
Permit No. 23405

40-21 ✓
29728