


23407
28208

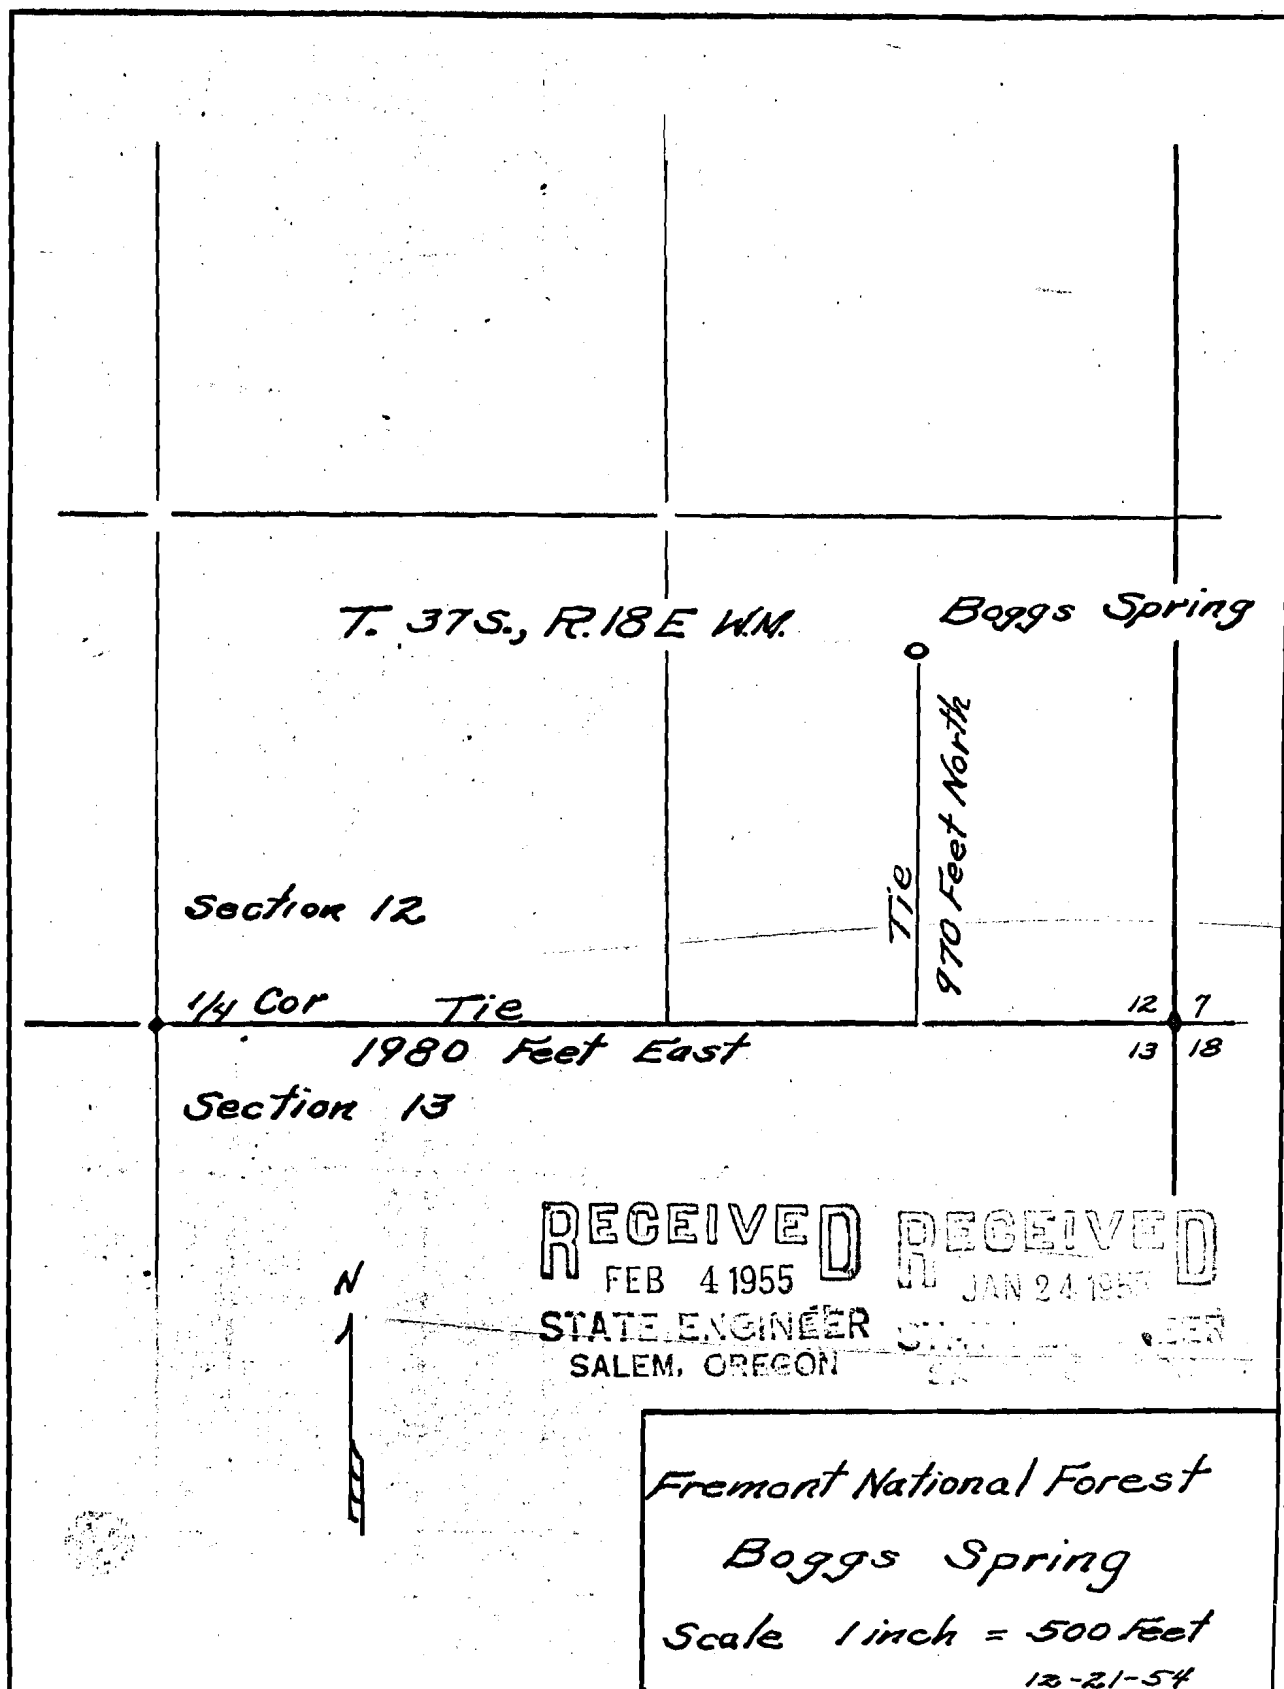

Application No. 29730
Permit No. 23407

29730 37-18