

FREMONT NATIONAL FOREST Unit
(Case designation)


DEPARTMENT OF AGRICULTURE
FOREST SERVICE
FIELD MAP SHEET

Unit WARNER DISTRICT

Scale 4 inches = 1 mile.

T. 395 R. 21E Sec. 23, 141

Mag. Dec. _____ Acres _____

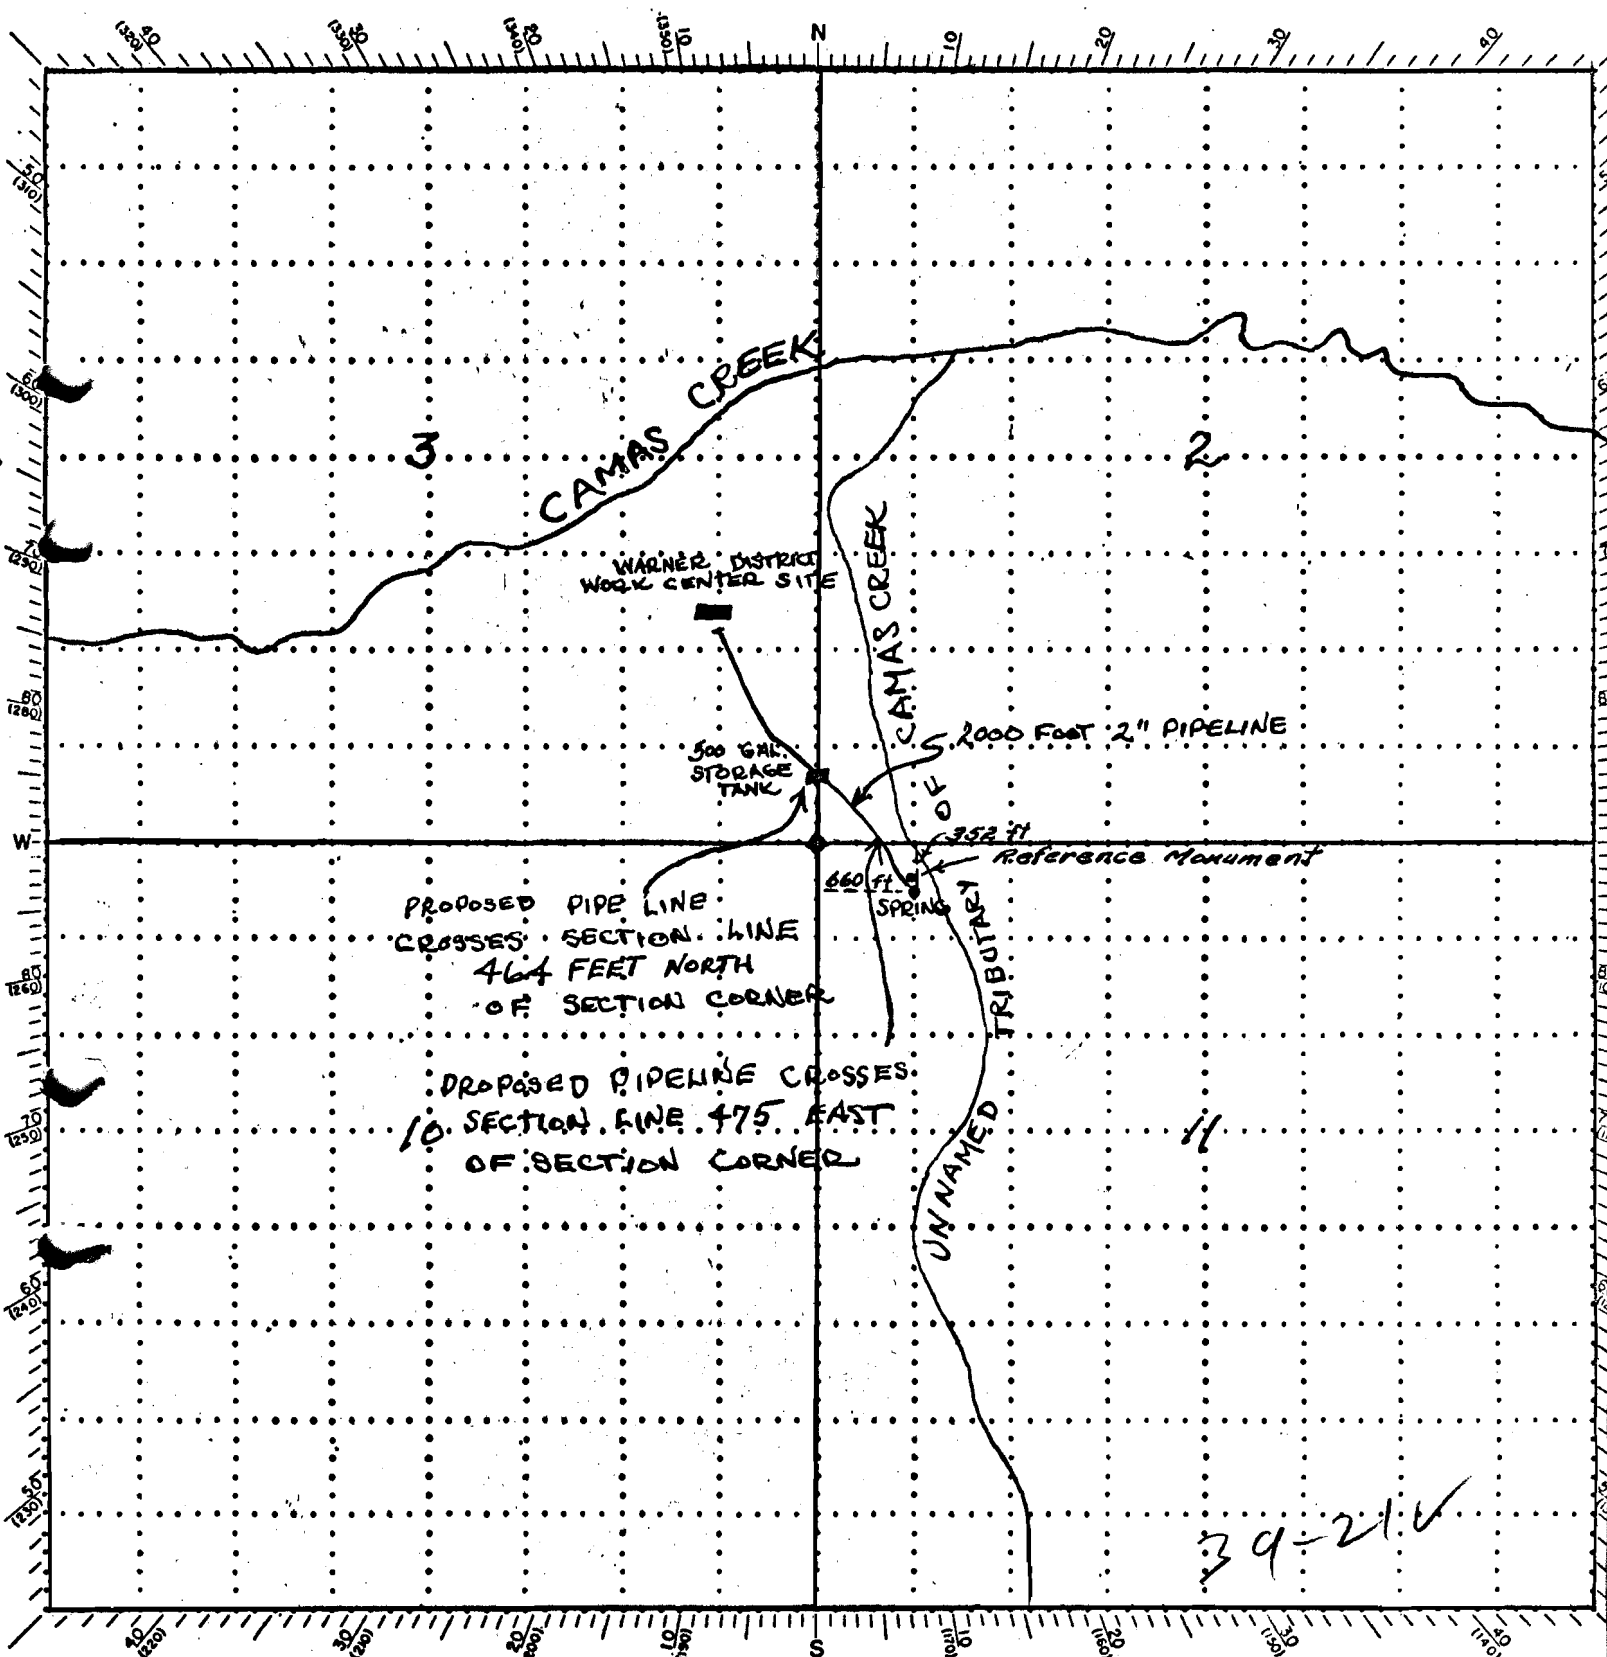

Field work by E.C. CARLSON

Date AUGUST 26, 1957

Platted by C.E. PEAROCK

Remarks

Application No. 31870

Approved

Permit No. 25122

Approving Officer,