


T.17S.R.4W.W.M.

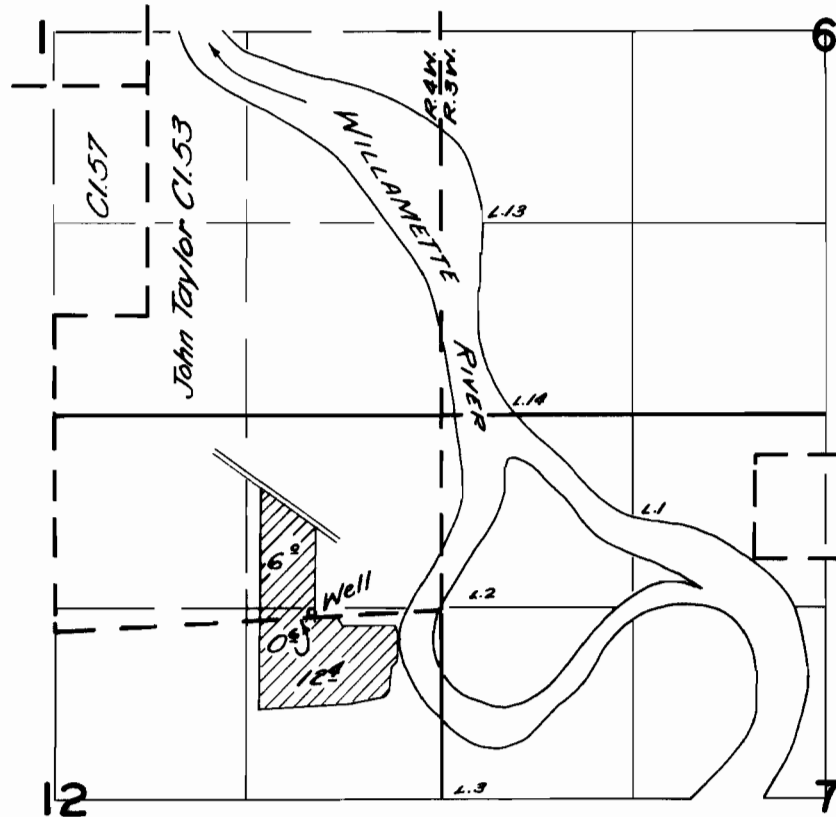

FINAL PROOF SURVEY UNDER

Application No. *G-1111*..... Permit No. *G-952*.....
IN NAME OF

.....*ORVE E. NEUSCHWANDER*.....

Surveyed *April 28 1960*, by *C.O. Baitels*.....