


T. 18 S. R. 2 W. W. M.

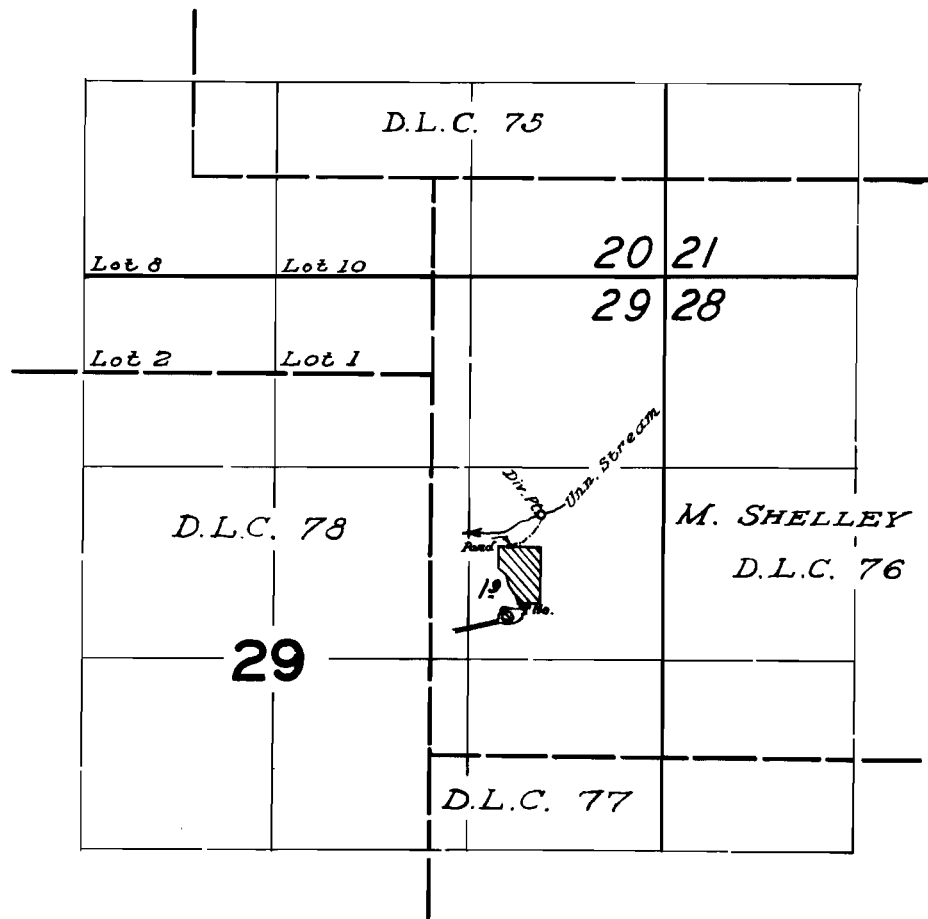

FINAL PROOF SURVEY
UNDER

Application No. 27455... Permit No. 21491...
IN NAME OF

CHARLES B. RYAN

Surveyed May 2 1960, by Al Jackson