


T.16S. R.6W.W.M.

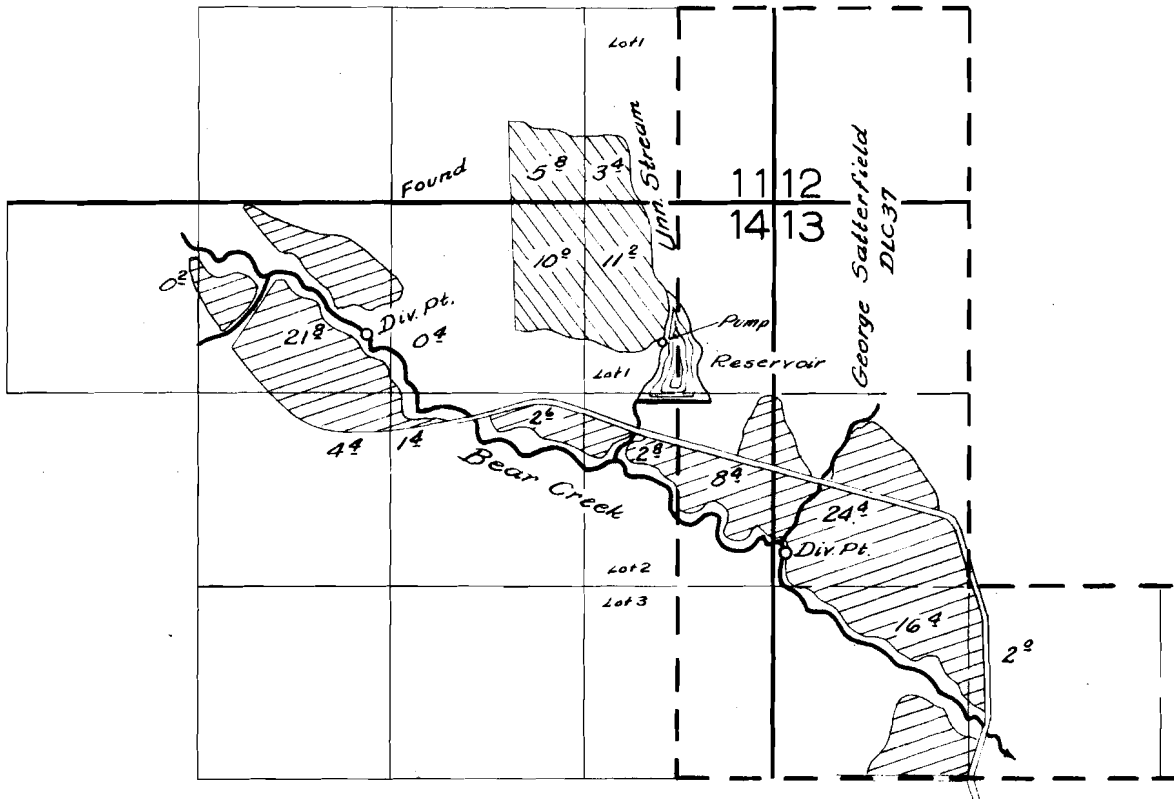

FINAL PROOF SURVEY
UNDER

Application No. *R-27073* 27074 Permit No. *R-1383* 21518
IN NAME OF

WILLARD M. POWELL

Surveyed April 1, 1959, by *COBART*