


T.21S.R.2W.M.

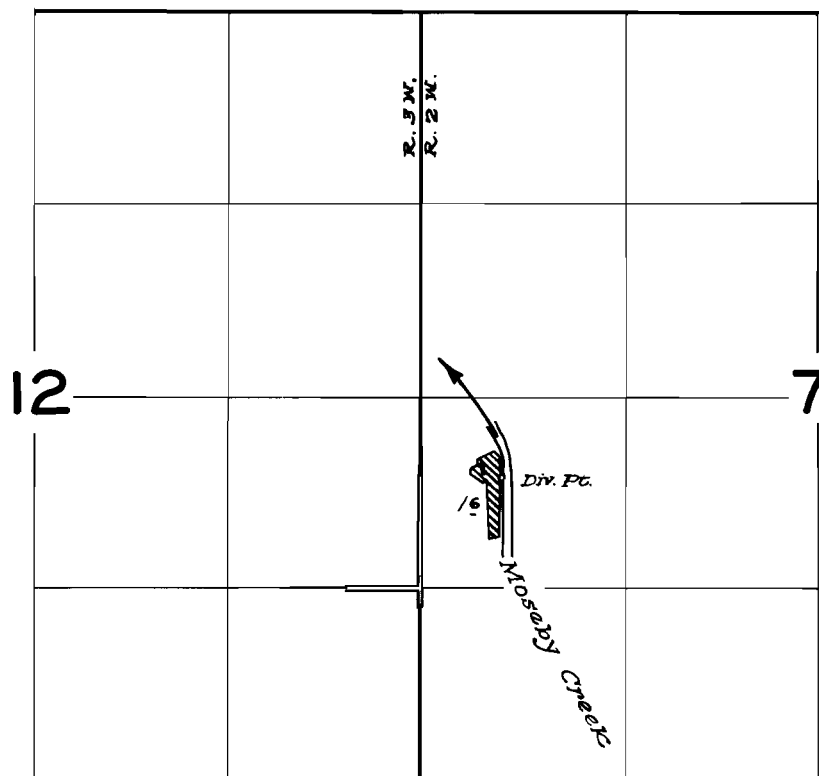

FINAL PROOF SURVEY
UNDER

Application No. 27991... Permit No. 22031..
IN NAME OF

JESSE FORRESTER

Surveyed May 3... 1960, by *Rt Jackson*