


T.18S. R.1W.W.M.

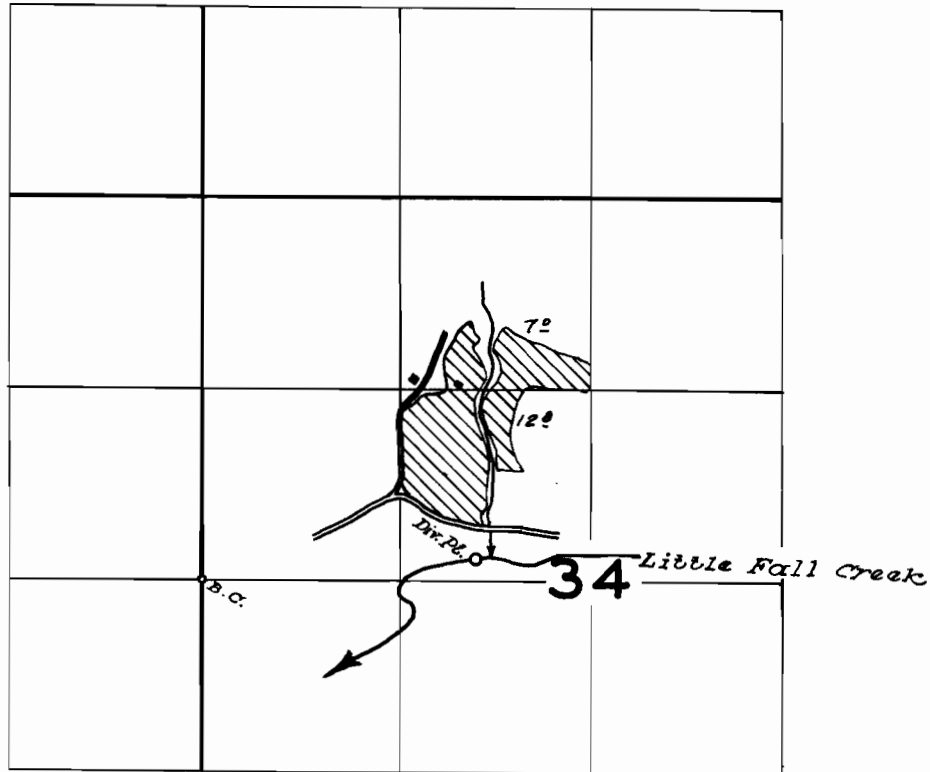

FINAL PROOF SURVEY
UNDER

Application No. 29887 Permit No. 23536
IN NAME OF

GALEN TIMBERMAN

Surveyed May 10, 1960, by *R.H. Jackson*