


T.18S. R.1W.W.M.

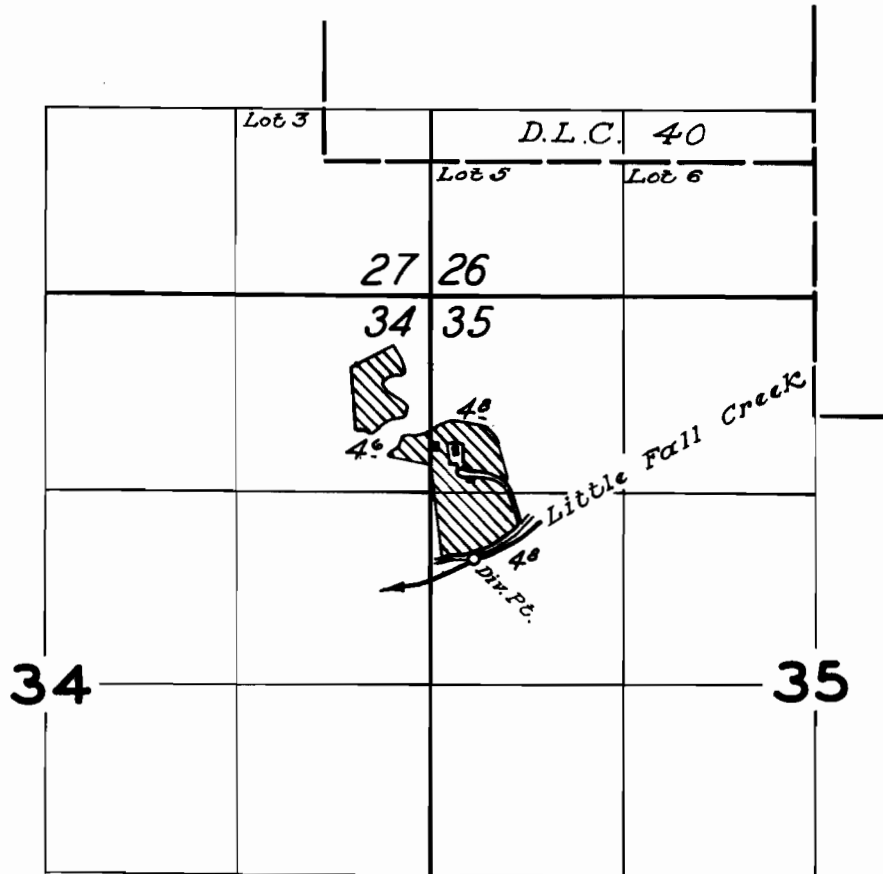

FINAL PROOF SURVEY
UNDER

Application No. 32076 Permit No. 25307
IN NAME OF

ERNEST JANSSEN

Surveyed May 10, 1960, by *A. H. Jackson*