


T.16S.R.4W.W.M.

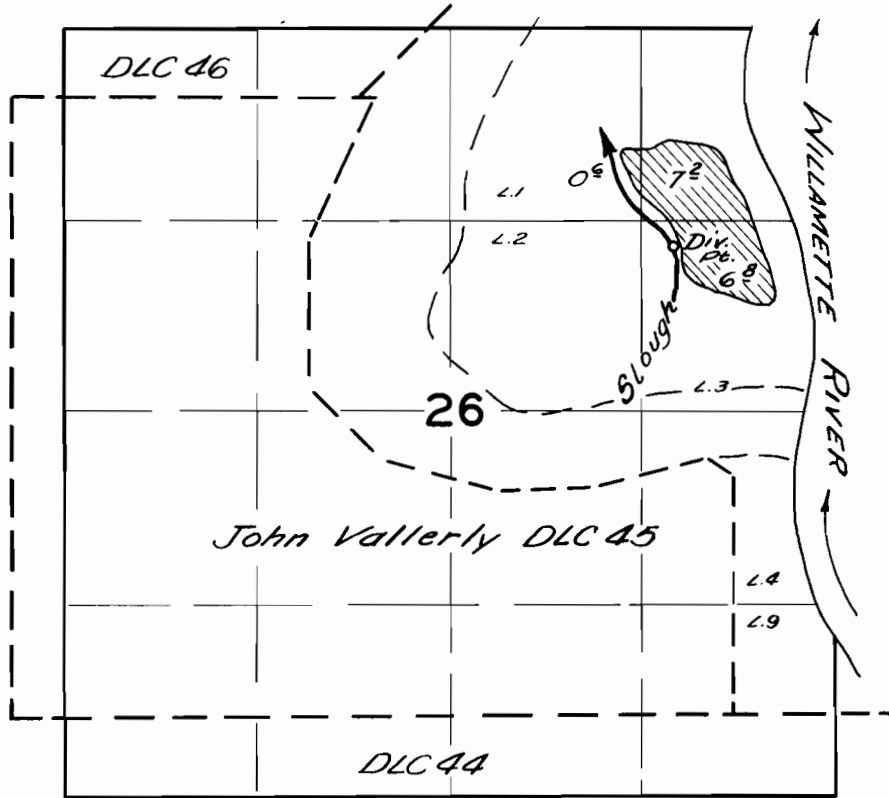

**FINAL PROOF SURVEY**  
UNDER

Application No. 32430... Permit No. 25601...  
IN NAME OF

*GORDON F. KELSO*

Surveyed *May 6*, 1960, by *C. O. Bartels*