


T. 18 S. R. 1 W. W. M.

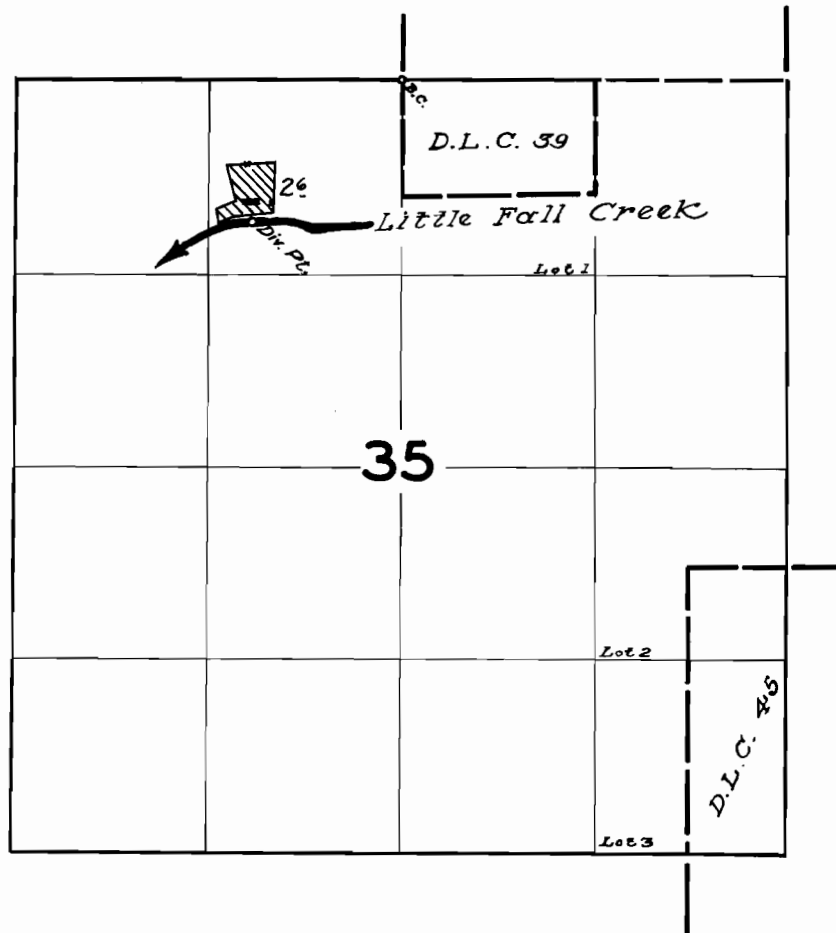

FINAL PROOF SURVEY
UNDER

Application No. 32433. Permit No. 25604.
IN NAME OF

E. L. MARTIN

Surveyed May 4, 1960, by *R. Jackson*