


T.18S. R.1W.W.M.

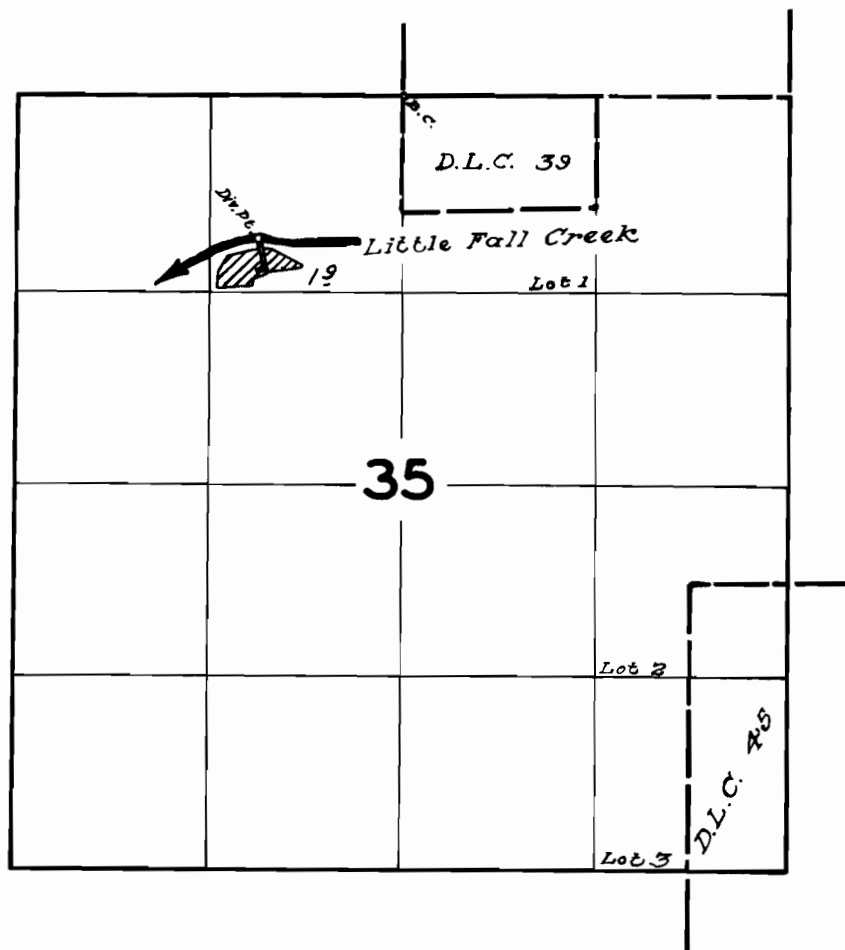

FINAL PROOF SURVEY
UNDER

Application No. 32434 Permit No. 25605
IN NAME OF

SIMON P. HAMON

Surveyed May 4 1960, by *R. H. Jackson*