


T.18S.R.1W.W.M.

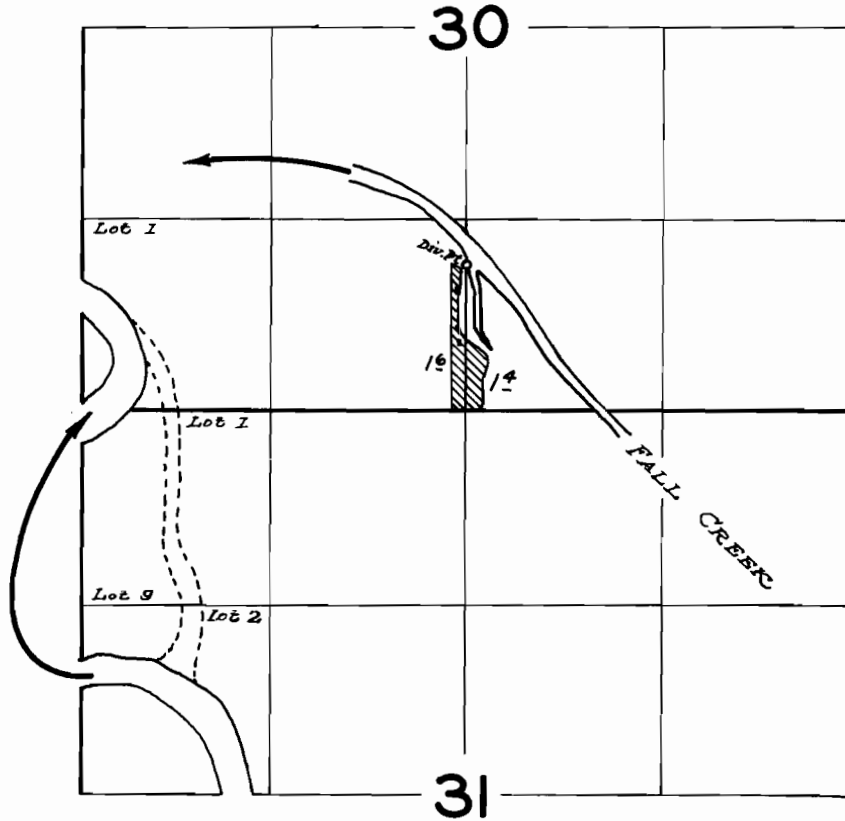

FINAL PROOF SURVEY
UNDER

Application No. 32542. Permit No. 25776.
IN NAME OF

MIKE ANHELUK

Surveyed May 10, 1960, by *R. Jackson*