


T.11S.R.11W.W.M.

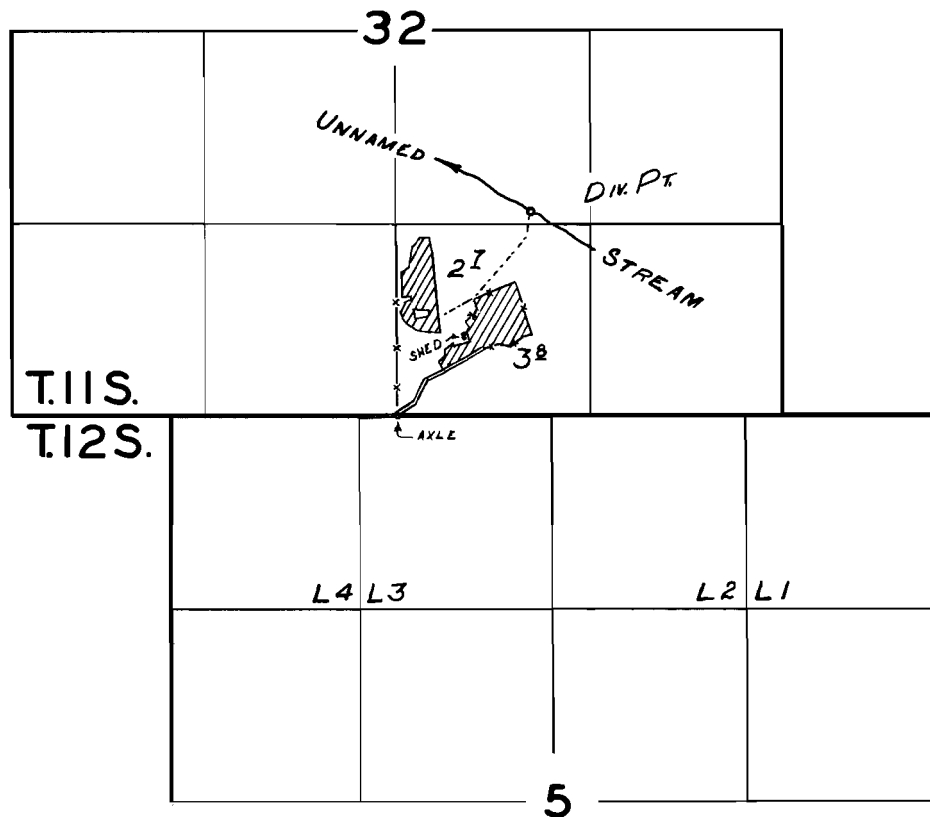

FINAL PROOF SURVEY
UNDER

Application No. 31331 Permit No. 24621
IN NAME OF

WARREN G. FERRIS

Surveyed AUG. 17 1960, by M. B. LSH