


T.IOS.R.IIW.W.M.

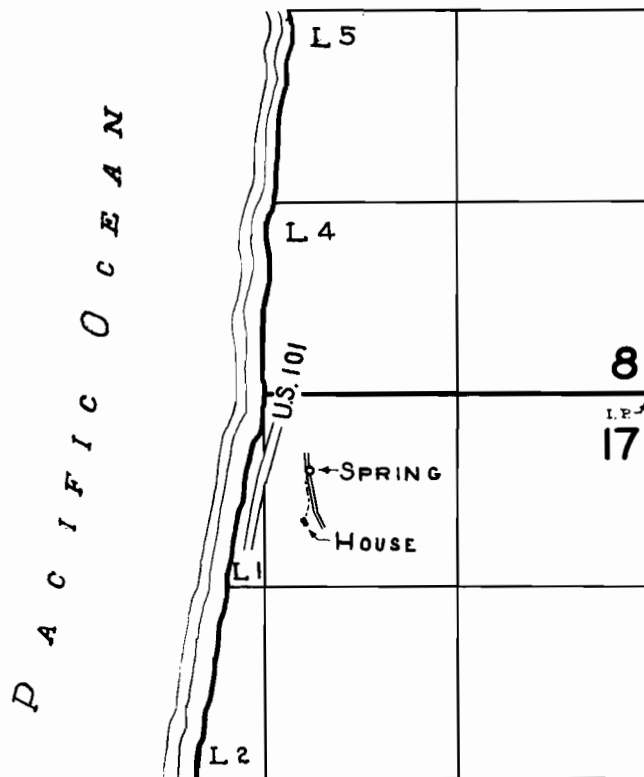

FINAL PROOF SURVEY
UNDER

Application No. 31477... Permit No. 24845.
IN NAME OF

MRs. ELLA DORLAND

Surveyed AUG. 17, 1960, by M. BISH

1960-E

112