


T.6&7S.R.10W.W.M.

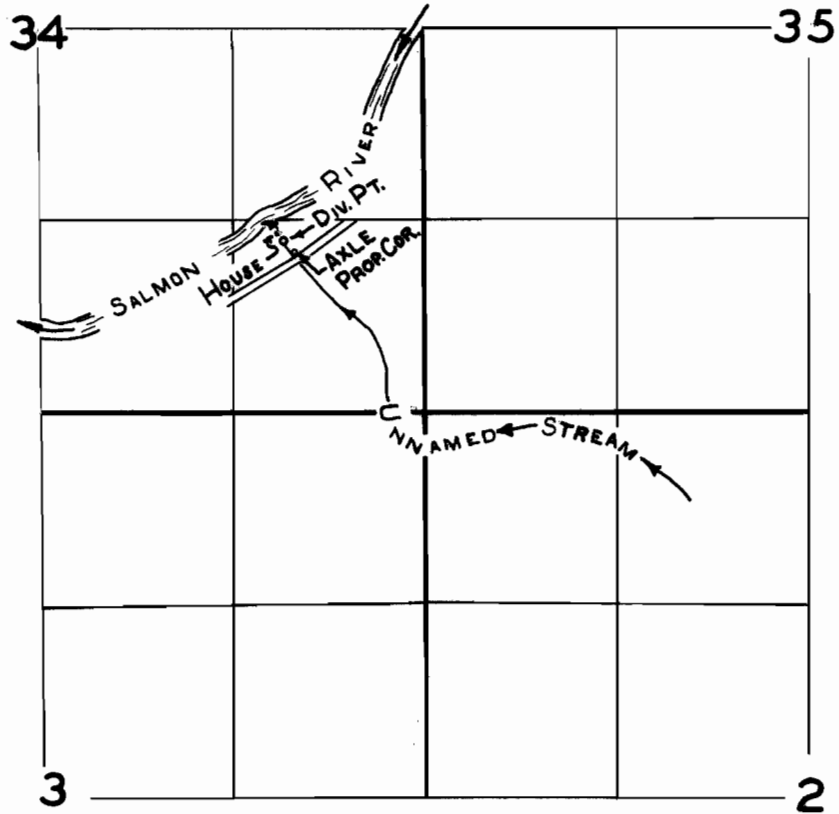

FINAL PROOF SURVEY
UNDER

Application No. 33232... Permit No. 26401...
IN NAME OF

RAY W. PIRTLE & HELEN GENEVIEVE PIRTLE

Surveyed Aug. 8 1960, by M BISH