


T.12S.R. 4W.W.M.

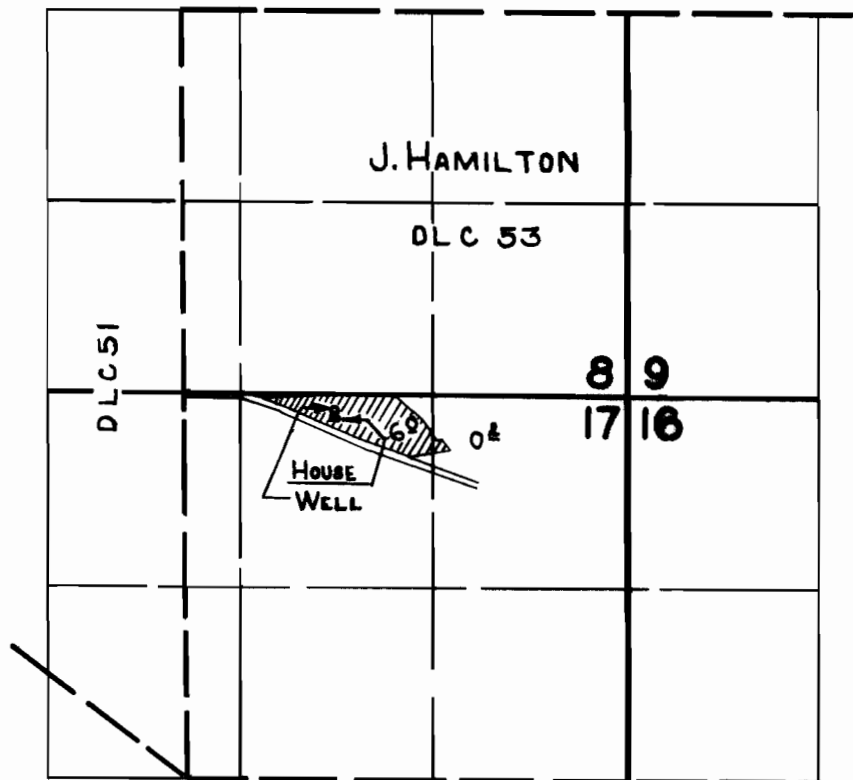

FINAL PROOF SURVEY
UNDER

Application No. G-1058 Permit No. G-1148.....
IN NAME OF

DANE J. PURVINE

Surveyed AUG. 3 1960, by M. BISH.....