


T.15S. R. 3W.W.M.

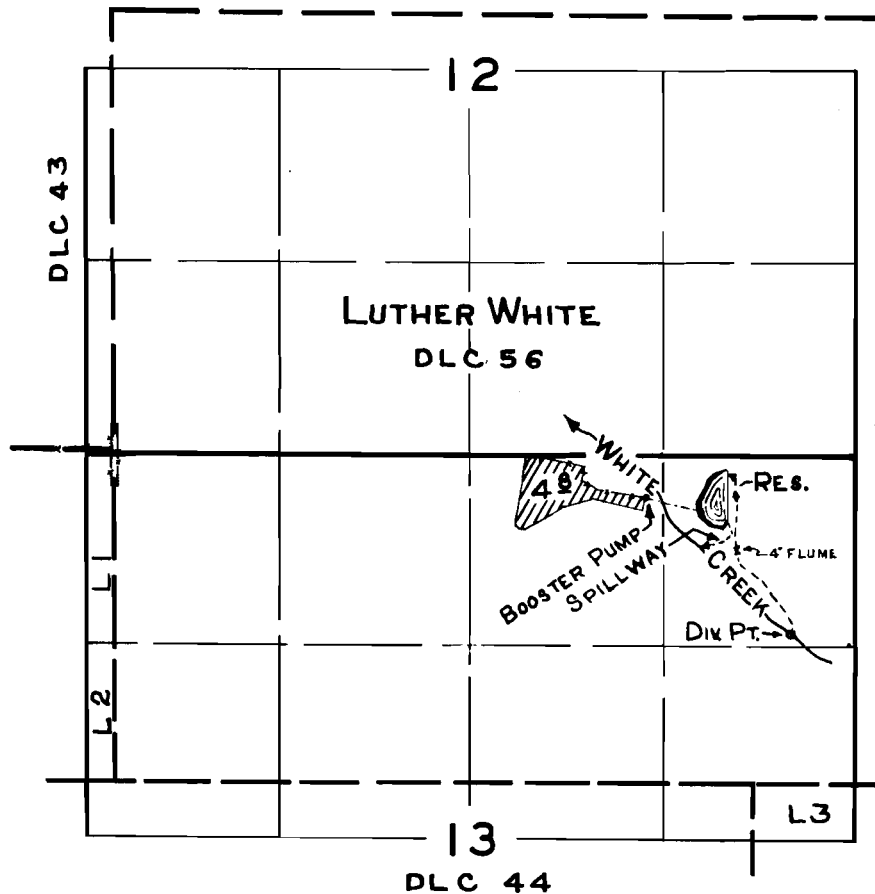

FINAL PROOF SURVEY
UNDER

R-30374 R-1790
Application No. 30049 Permit No. 23760
IN NAME OF

FERRIS A. & MARTHA DODD

Surveyed JULY 29 1960, by M.V. BISH