


T.14S. R.2E.W.M.

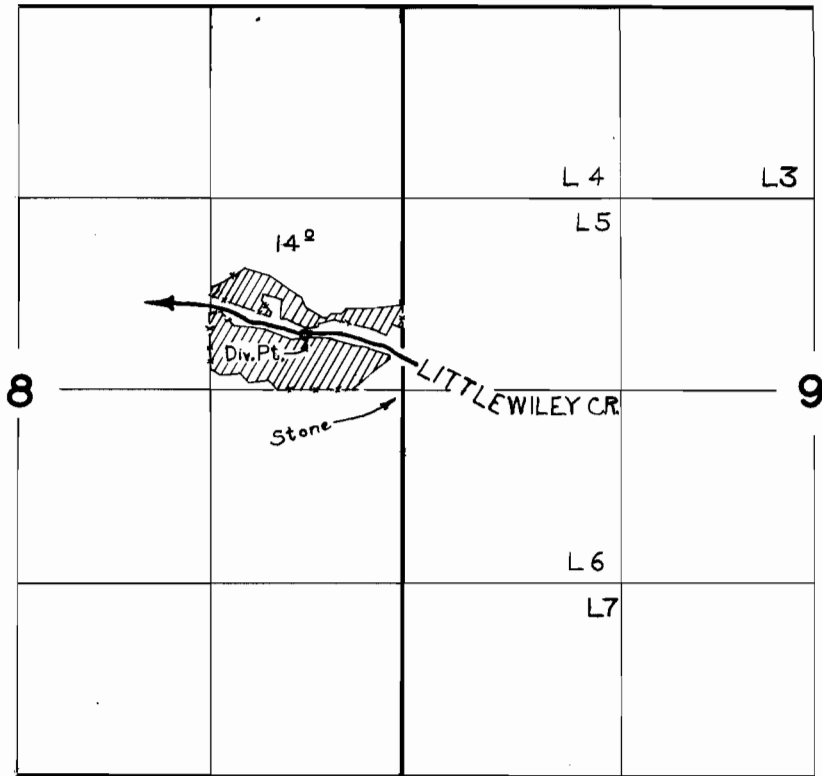

FINAL PROOF SURVEY UNDER

Application No. 30425 Permit No. 23985
IN NAME OF

ALFRED E. & MABEL J. NASLUND

Surveyed MAY 11 1960, by M. BISH