


T. 9 S. R. 1 W. W. M.

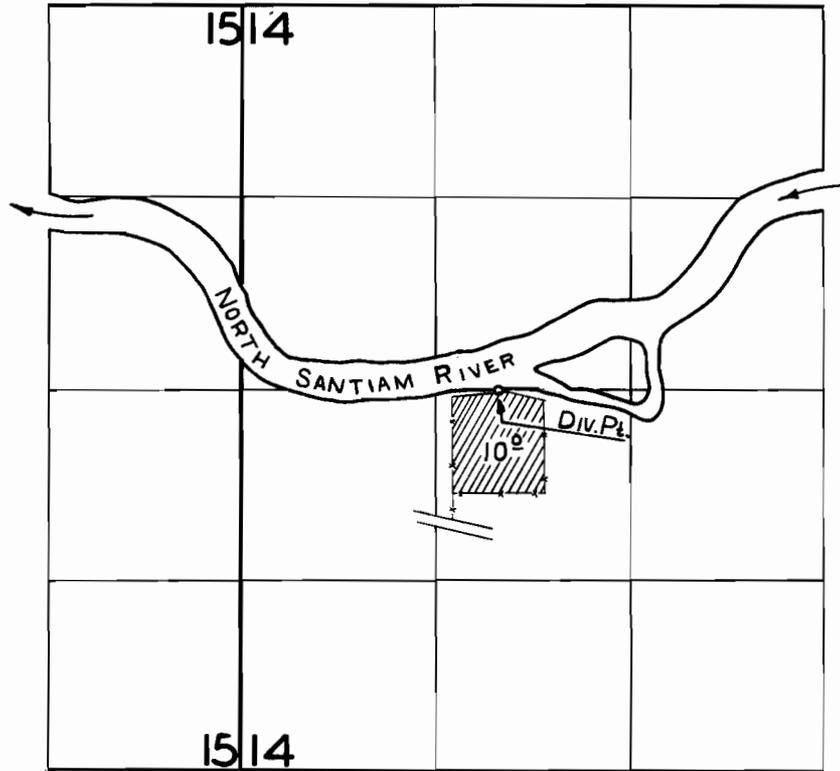

FINAL PROOF SURVEY
UNDER

Application No. 30894... Permit No. 24284...
IN NAME OF

..... RICHARD T. UDEY

Surveyed JULY 7 1960, by M. BISH