


# T. 10S. R. 2W. W.M.

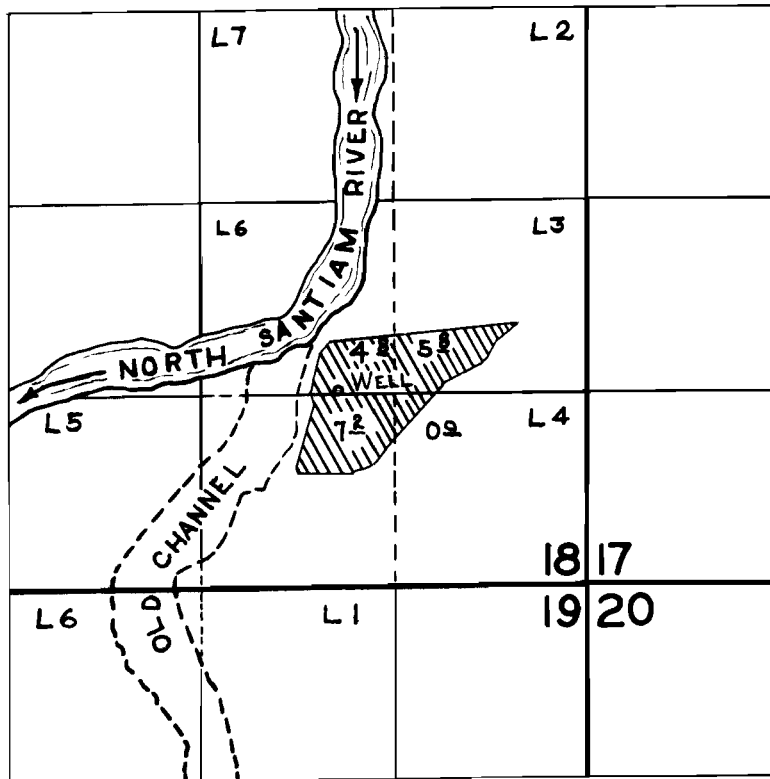

## FINAL PROOF SURVEY UNDER

Application No. G. 995 Permit No. G. 845  
IN NAME OF

DALE EISENMANN

Surveyed JULY 5, 1960, by M. BISH