


T. 12 S. R. 4 W. W.M.

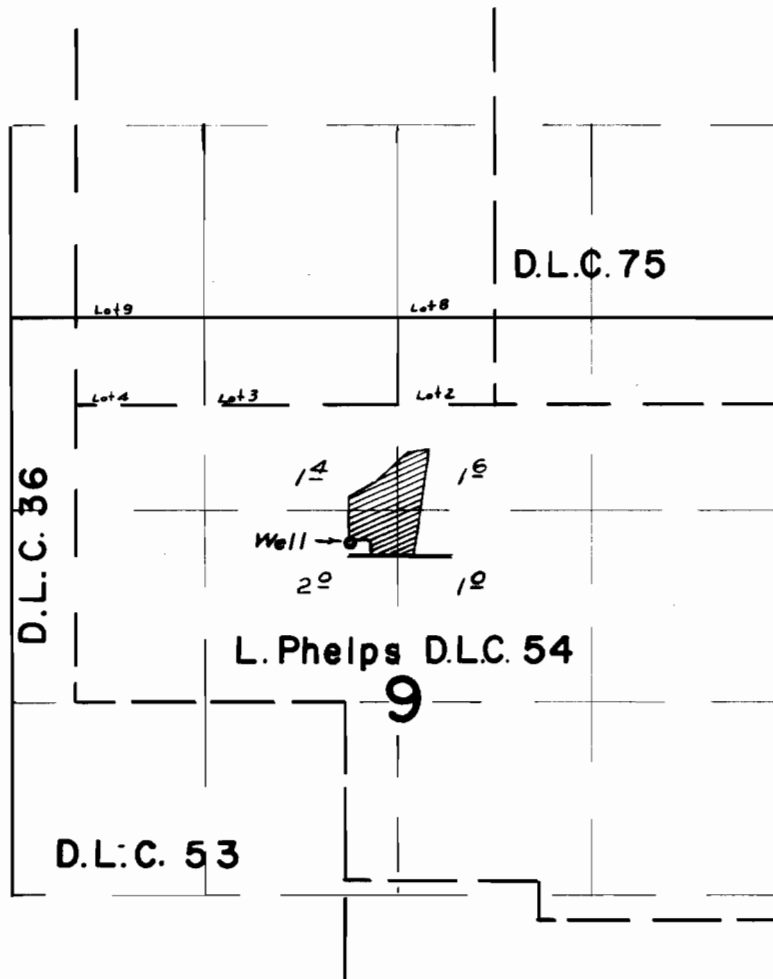

FINAL PROOF SURVEY
UNDER

Application No. G-1190 Permit No. G-998
IN NAME OF

ROBERT L. & EUNICE B. ARTHUR

Surveyed 3 AUG 1960, by Mr. Bish