


T.14S. R.38 E.W.M.

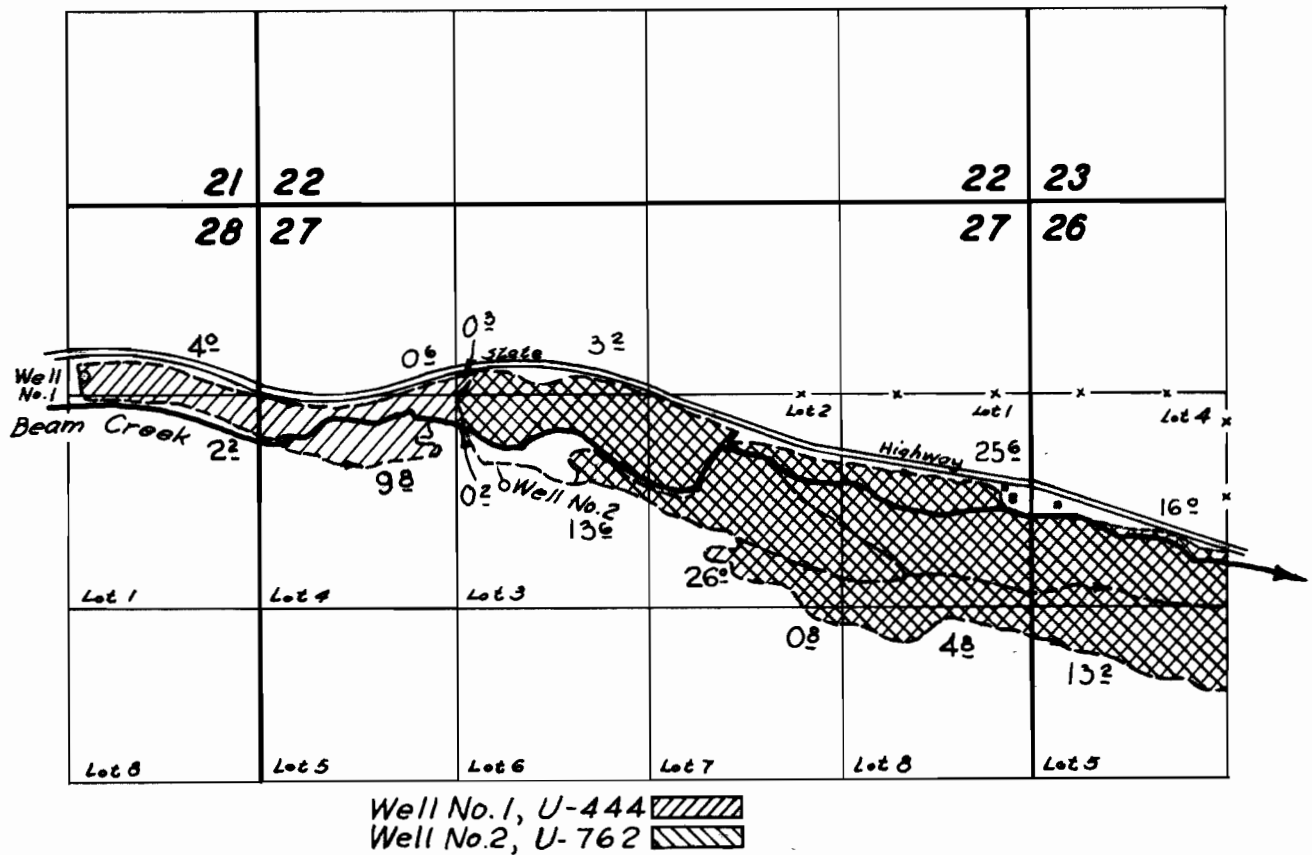

FINAL PROOF SURVEY
UNDER

U-444 U-415
Application No. U-762 Permit No. U-685
IN NAME OF

RALEIGH VAN BUREN

Surveyed 16 Oct. 1958, by C.O. Bartels.