




T.14S. R.38 E.W.M.

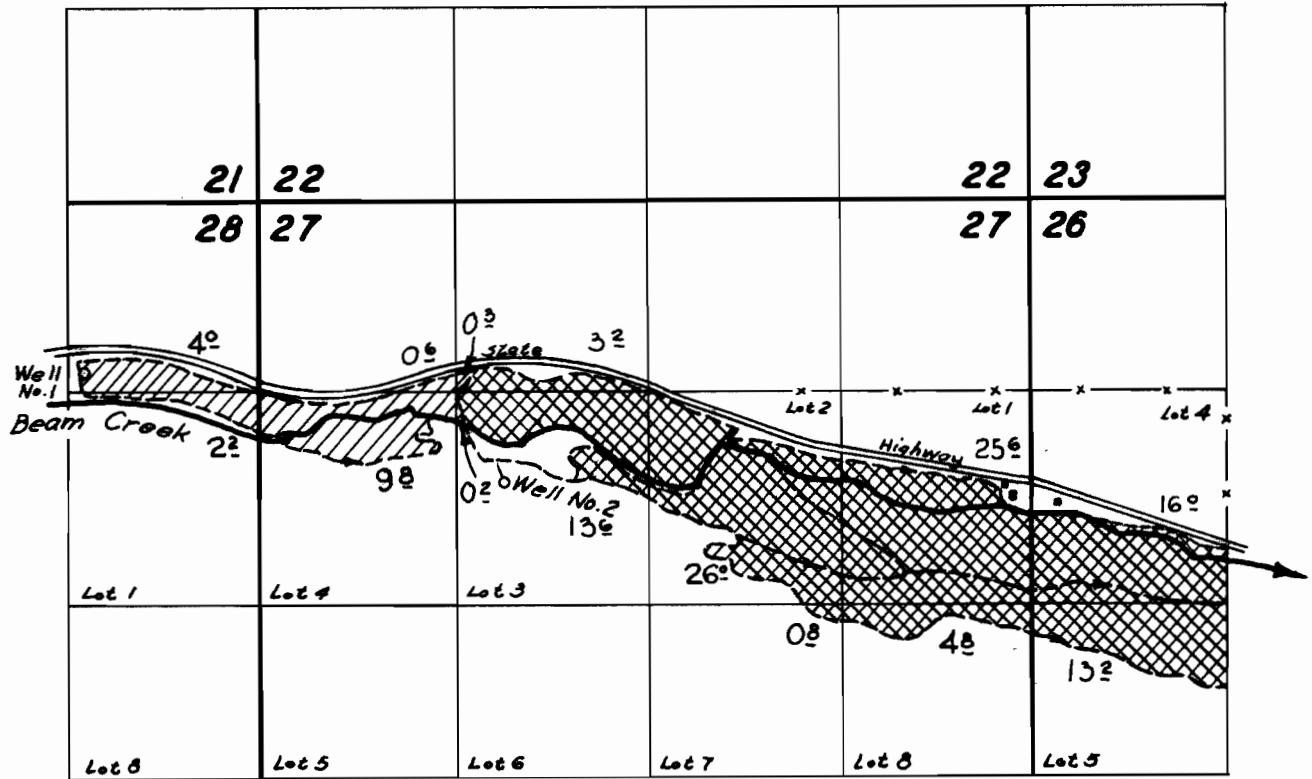

Well No. 1, U-444 
 Well No. 2, U-762 

FINAL PROOF SURVEY
 UNDER

U-444 U-415
 Application No. U-762 Permit No. U-685
 IN NAME OF

RALEIGH VAN BUREN

Surveyed 16 Oct. 1958, by C.O. Bartels.