


T. 6S. R. 2W. W.M.

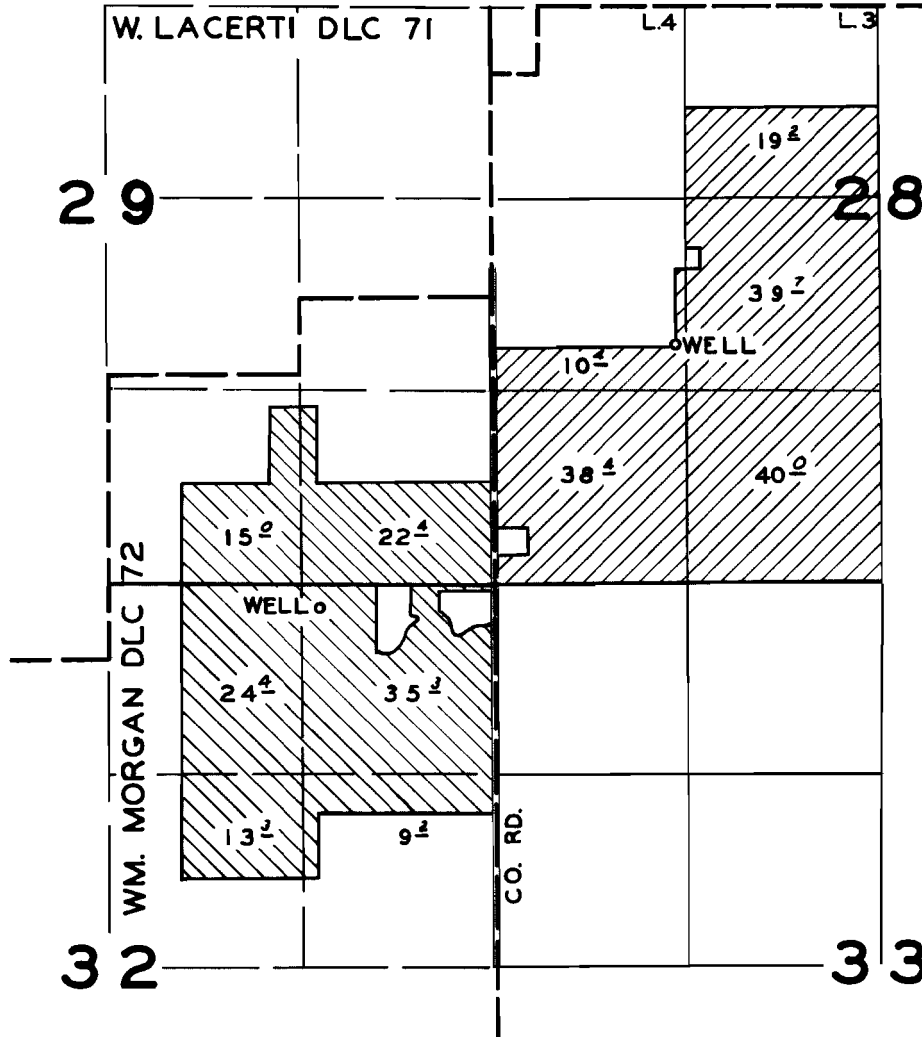

FINAL PROOF SURVEY UNDER

Application No. G 259 G.558 Permit No. G163 G.458 
IN NAME OF

ALVIN J. VAN CLEAVE

Surveyed MAY 24 1960, by C.O. BARTELS