


T. 6S. R. 2W. W.M.

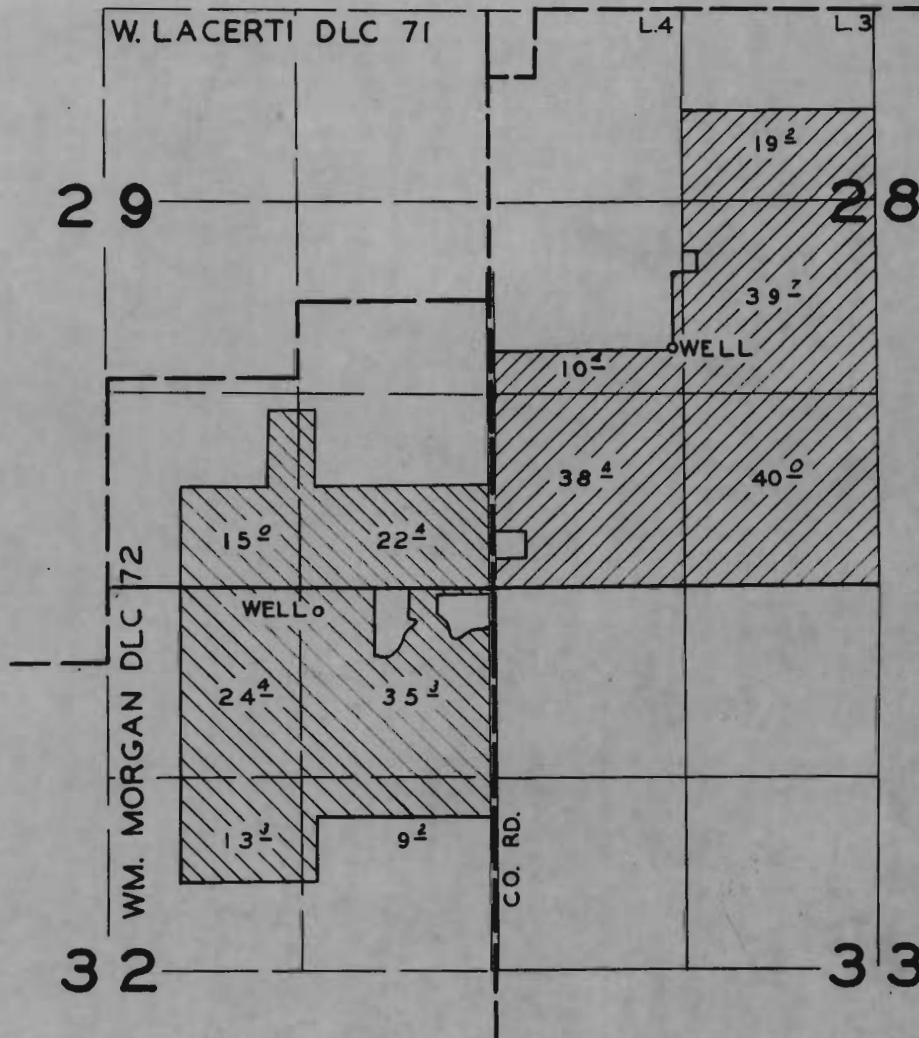

FINAL PROOF SURVEY UNDER

Application No. G 259 G 558 Permit No. G 163 G 458

IN NAME OF

ALVIN J. VAN CLEAVE

Surveyed MAY 24, 1960, by C. O. BARTELS