T. 6S. R. 2W. W.M.

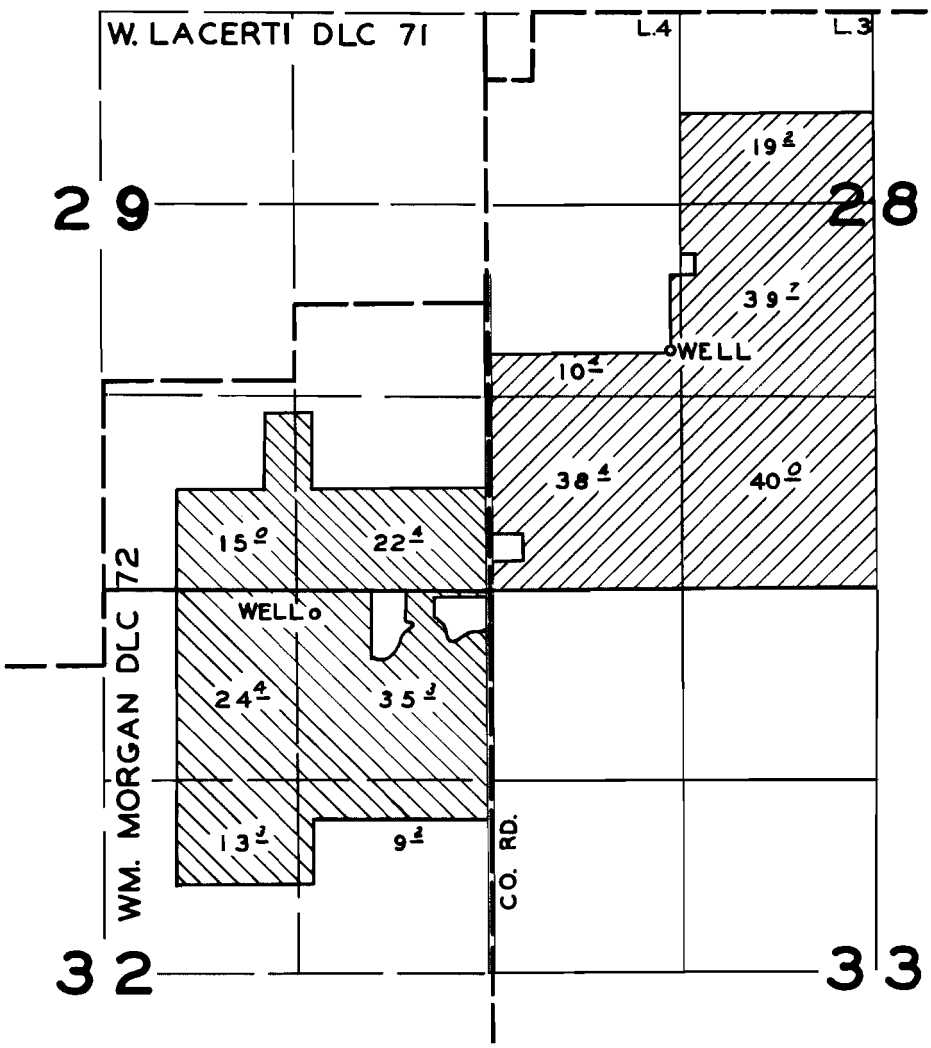

FINAL PROOF SURVEY
UNDER

Application No. G259 G.558 Permit No. G163 G.458

IN NAME OF

ALVIN J. VAN CLEAVE

Surveyed MAY 24 19 60, by C.O. BARTELS

DFN-IP-29872 L.j.