


T. 4&5S. R.1W. W.M.

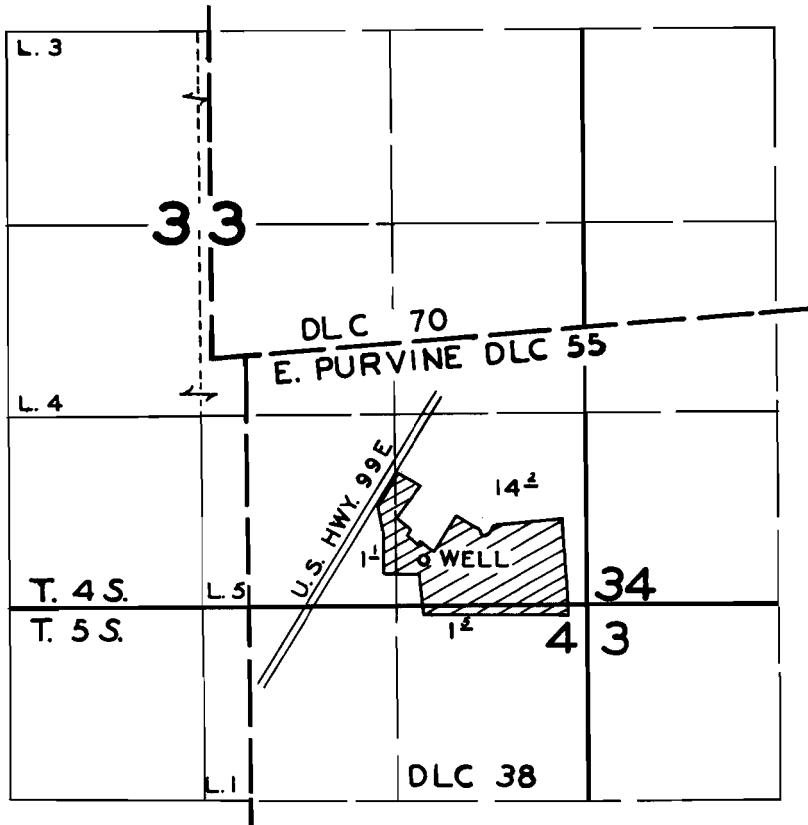

FINAL PROOF SURVEY
UNDER

Application No. G.5.94..... Permit No. G.500.....
IN NAME OF

.....WALTER SCHMIDT.....

Surveyed MAY 24 1960, by C.O. BARTELS.....