


T. 8S. R. 2W. W.M.

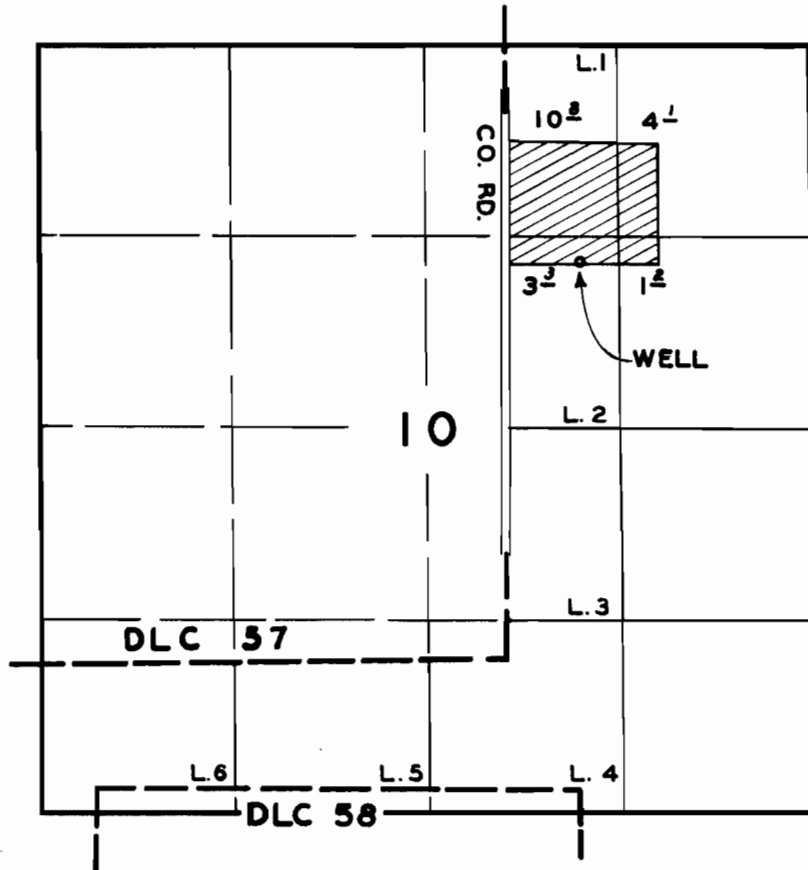

**FINAL PROOF SURVEY**  
UNDER

Application No. G.1165..... Permit No. G.1200.....  
IN NAME OF

..... C. J. DALLMAN .....

Surveyed MAY.16. 1960., by C. O. BARTELS.....