


T.7S.R.1E.W.M.

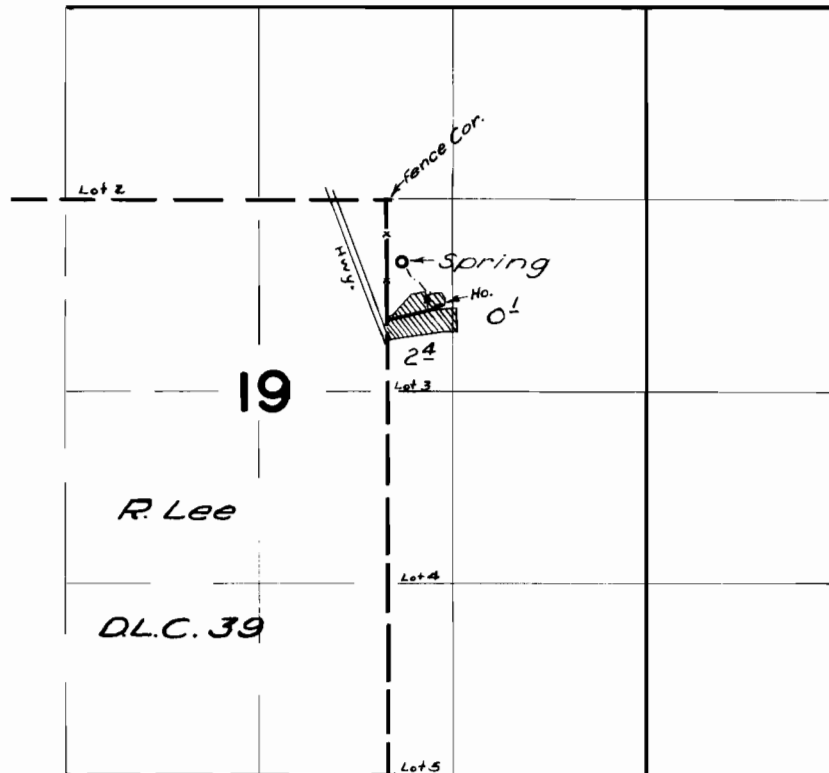

FINAL PROOF SURVEY
UNDER

Application No. 27421 Permit No. 21590
IN NAME OF

JOHN SHIMP

Surveyed 21 April 1960 by M. Bish