


T. 6S. R. 1W. W.M.

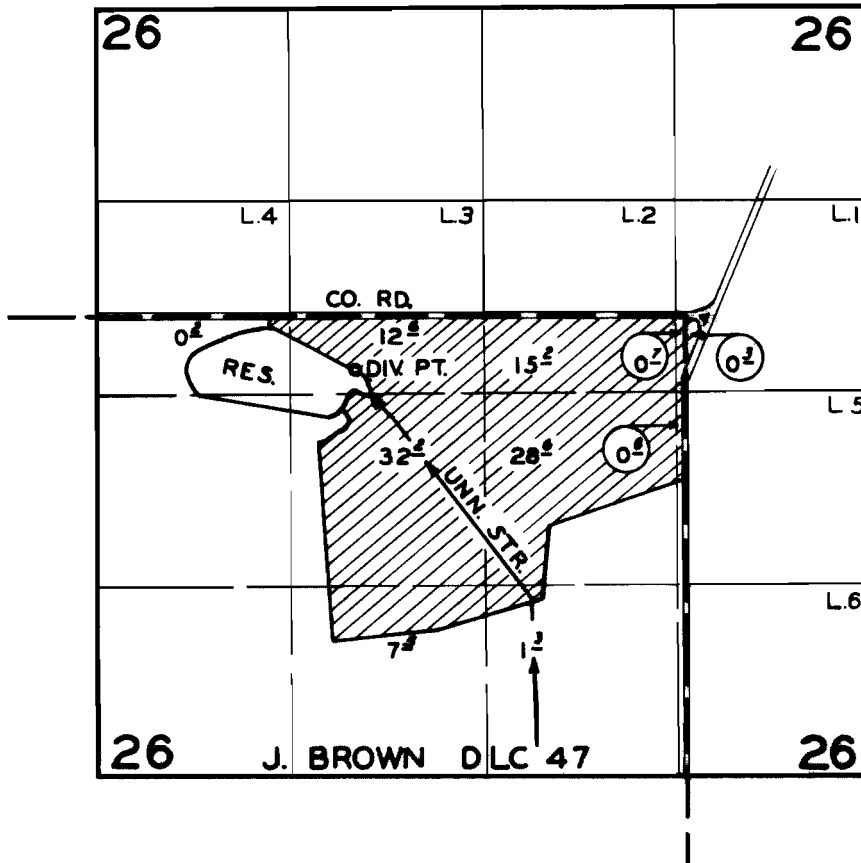

FINAL PROOF SURVEY UNDER

Application No. R 29392
29393 Permit No. R1666
232.17.
IN NAME OF

J. WESLEY WEBB

Surveyed NOV. 9 1960, by C. O. BARTELS