


T. 6S. R. 2W. W.M.

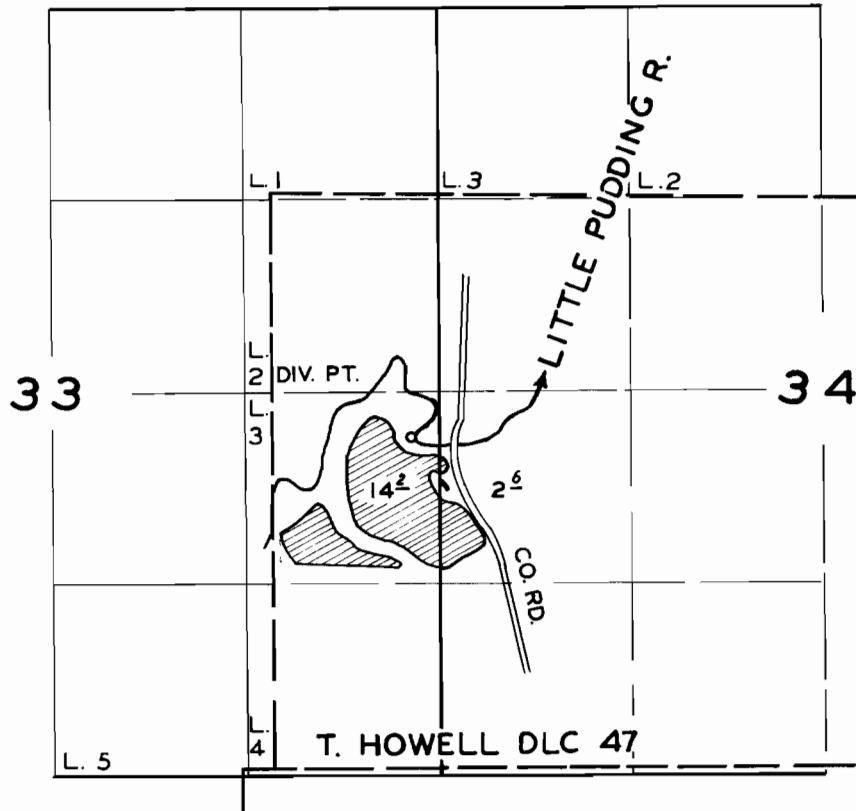

FINAL PROOF SURVEY
UNDER

Application No. 30558 Permit No. 24077
IN NAME OF

LEONARD & HENRI LANGPRE

Surveyed SEPT. 7, 1960, by C. O. BARTELS