


T. 8S. R. 3W. W.M.

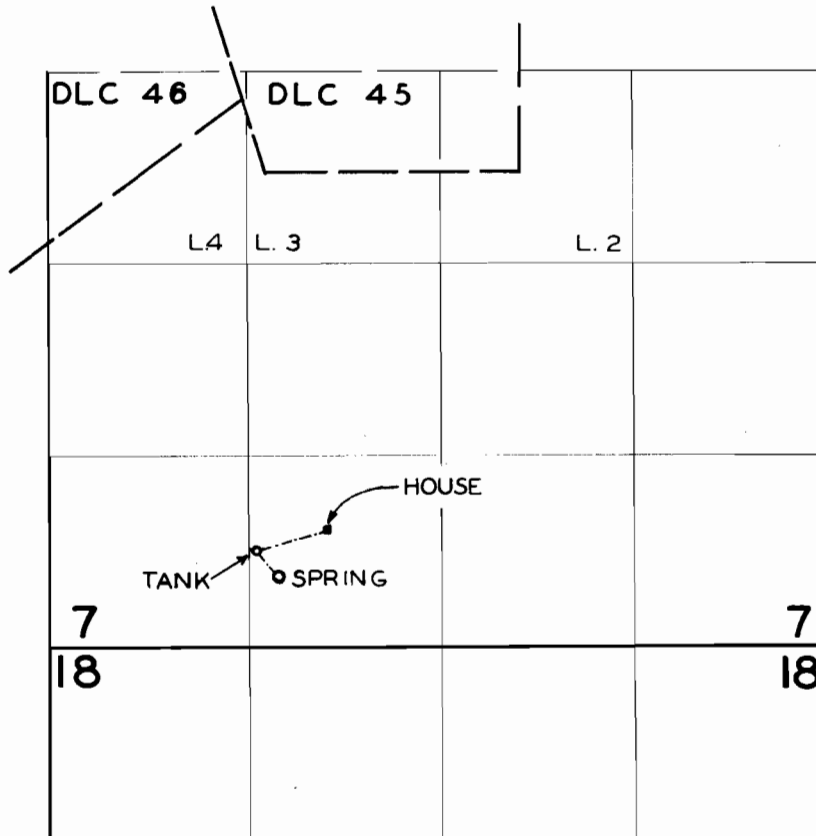

FINAL PROOF SURVEY
UNDER

Application No. 31097 Permit No. 24469
IN NAME OF

WALTER WILLIAM, JR. & MARGURITE FELLMAN

Surveyed SEPT. 9 1960, by C.O. BARTELS