


T. 4S. R. 1W. W.M.

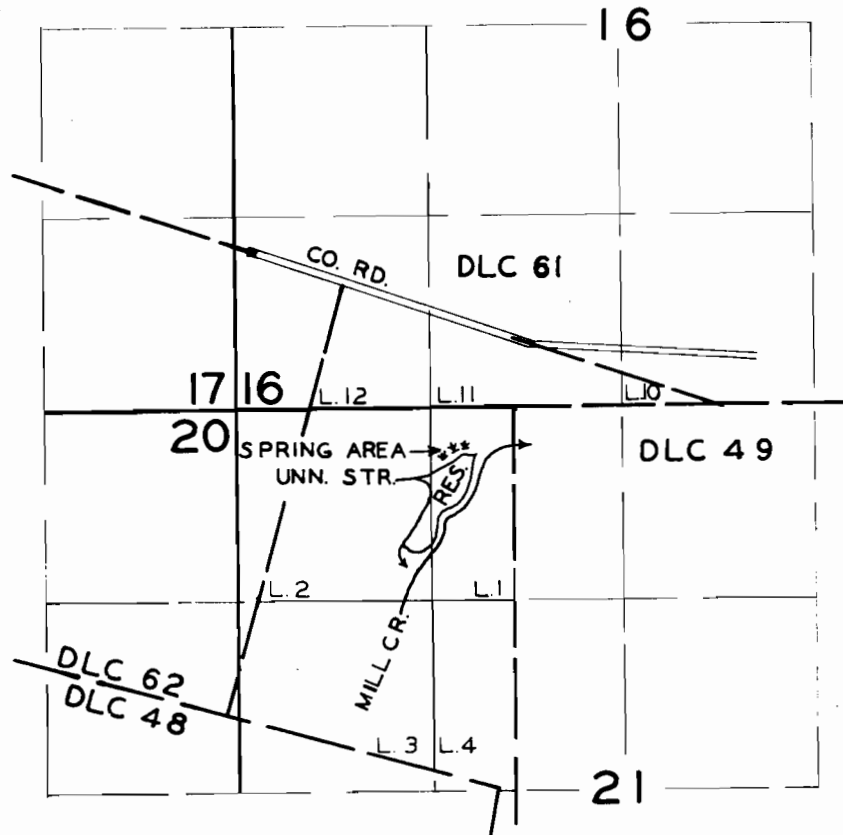

FINAL PROOF SURVEY
UNDER

Application No. R 31531 31532 Permit No. R 2036 24963
IN NAME OF

E.W. DEKONING

Surveyed SEPT. 7, 1960, by C.O. BARTELS

1960 W *JB*