


T.7 S.R.I.W.W.M.

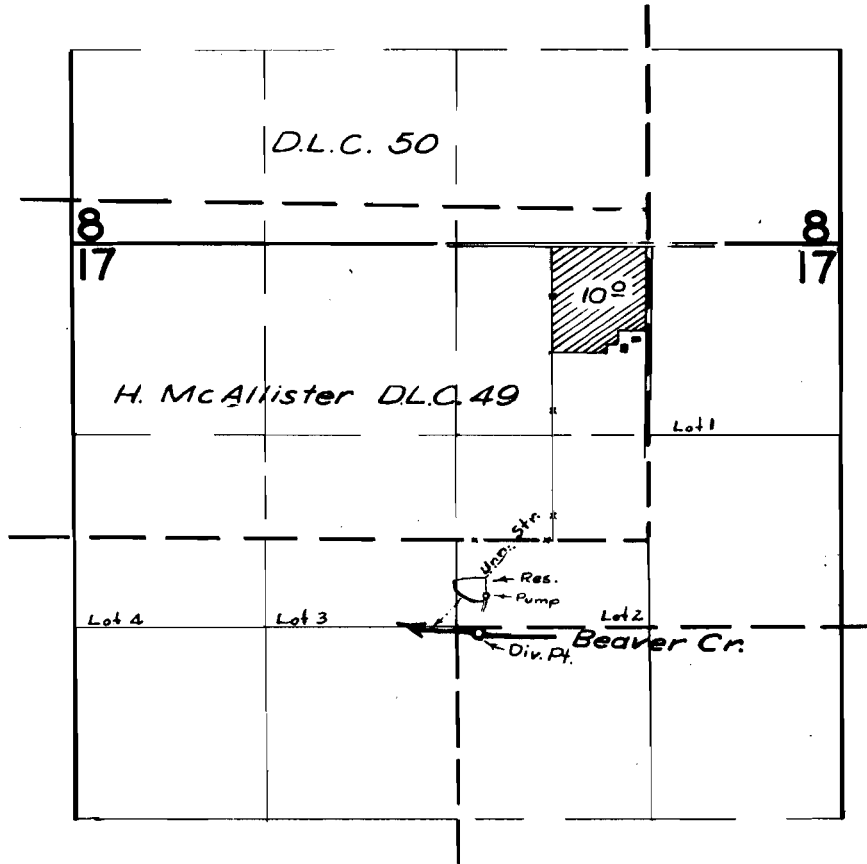

FINAL PROOF SURVEY UNDER

R-32727 R-2199
Application No. 32728 Permit No. 25837
IN NAME OF

EDWARD KUENZI

Surveyed 22 April 1960, by T. B. Bish