


# T.7 S.R.I.W.W.M.

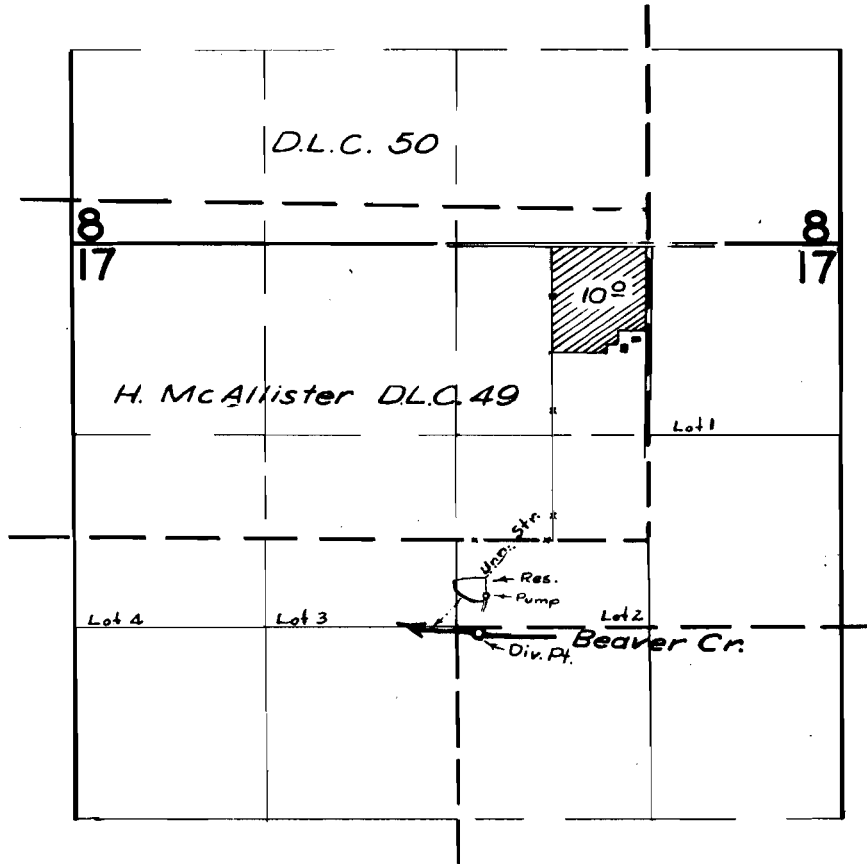

## FINAL PROOF SURVEY UNDER

R-32727      R-2199  
Application No. 32728 Permit No. 25837.  
IN NAME OF

EDWARD KUENZI .....

Surveyed 22 April 1960, by *Tr. Bish*..