


T.6 S.R. I W.W.M.

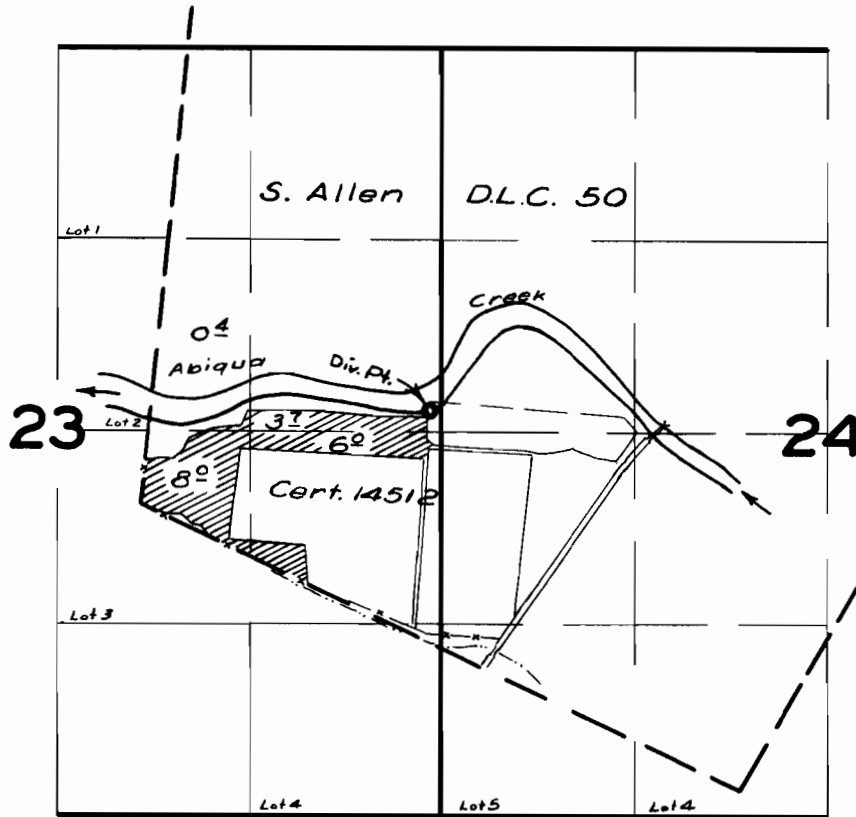

FINAL PROOF SURVEY UNDER

Application No. 32833 Permit No. 25912
IN NAME OF

HERMAN GOSCHIE

Surveyed 21 April 1960 by Tom B. Bish